
Antero Resources
Well No. Burke 1H
As-Drilled
Antero Resources Corporation

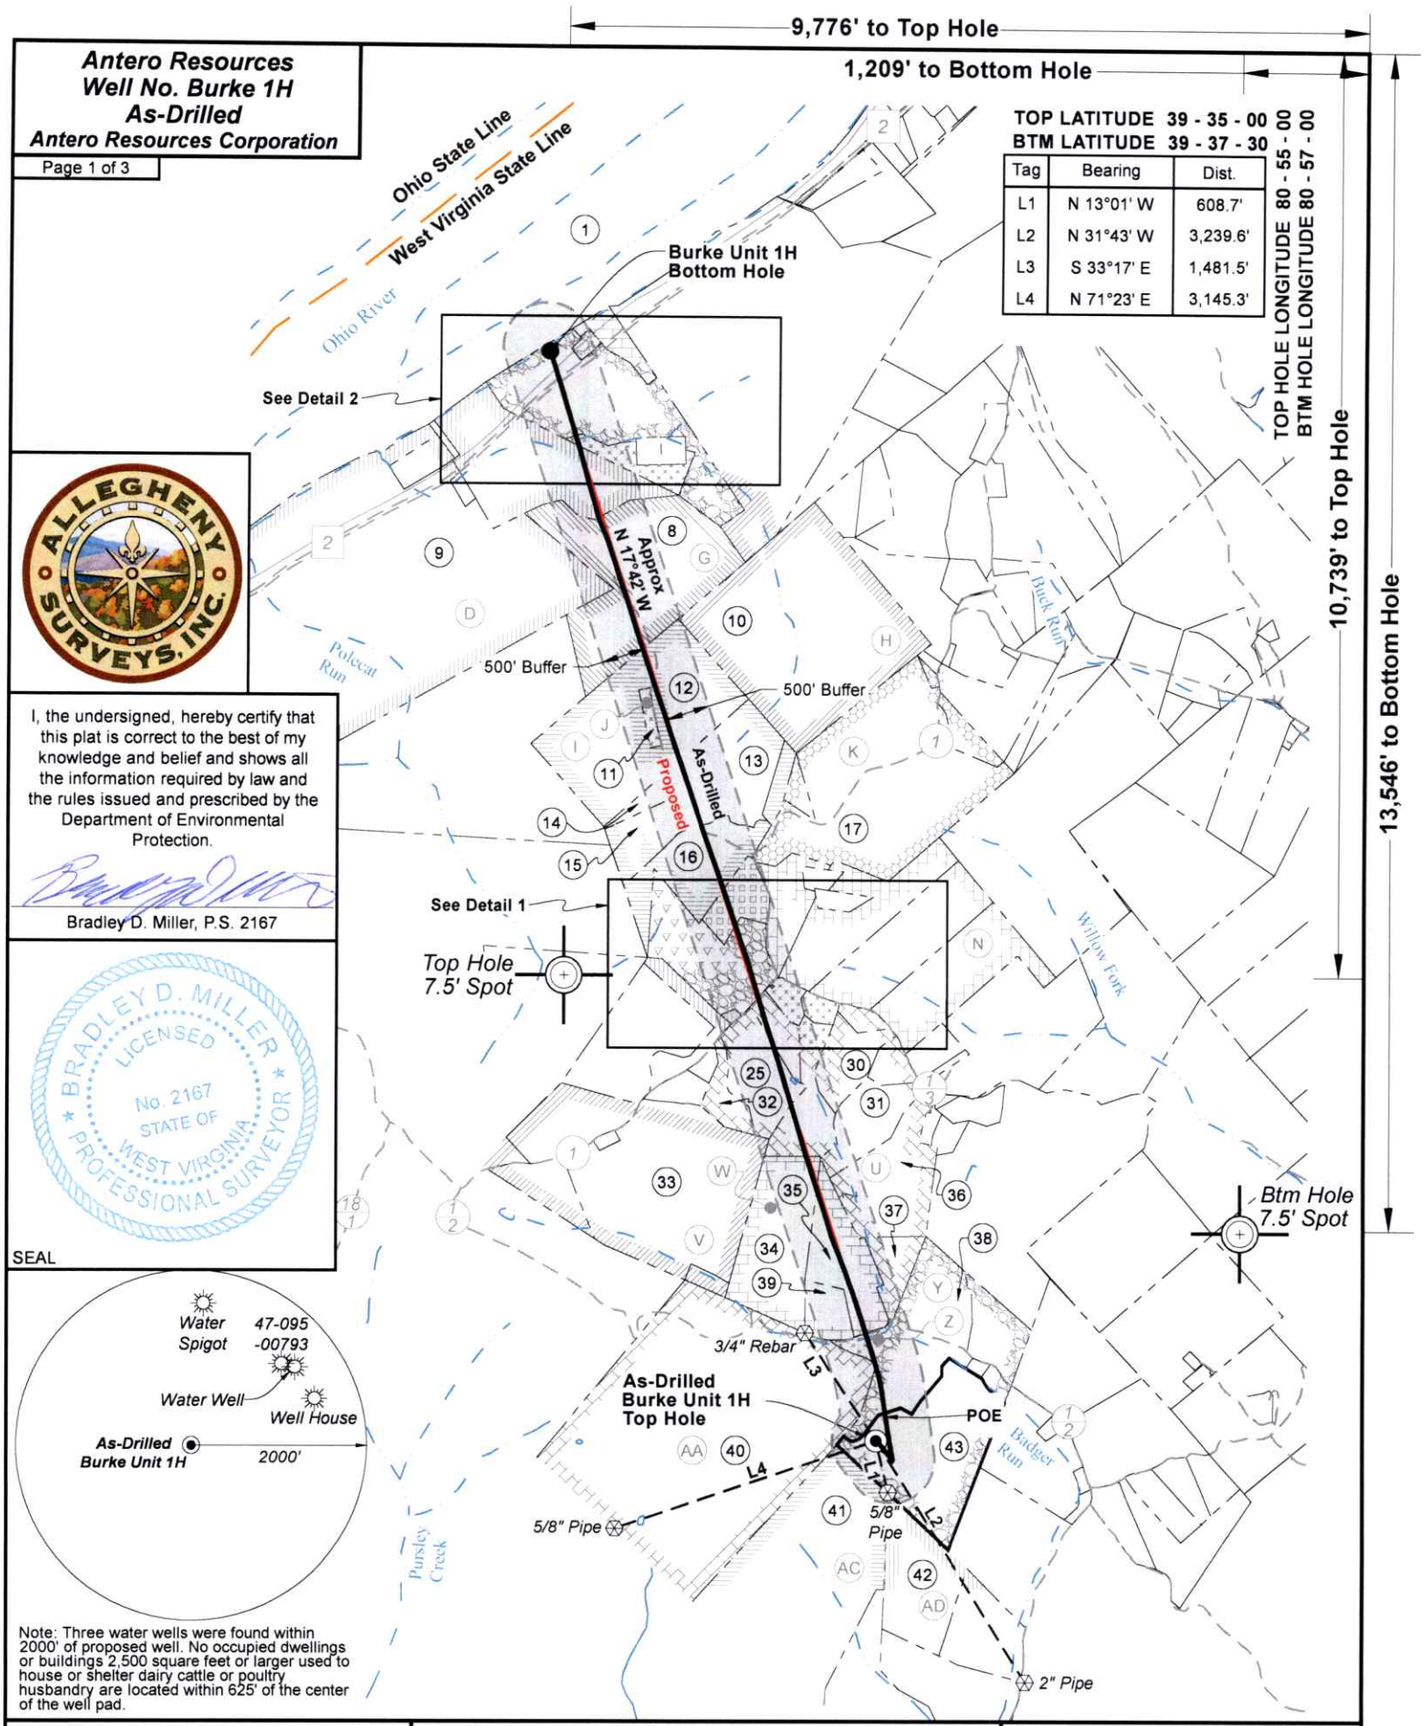

I, the undersigned, hereby certify that this plat is correct to the best of my knowledge and belief and shows all the information required by law and the rules issued and prescribed by the Department of Environmental Protection.

Bradley D. Miller, P.S. 2167

SEAL

Note: Three water wells were found within 2000' of proposed well. No occupied dwellings or buildings 2,500 square feet or larger used to house or shelter dairy cattle or poultry husbandry are located within 625' of the center of the well pad.

FILE NO: 162-54-L-23
DRAWING NO: Burke Unit 1H As-Drilled
SCALE: 1" = 2000'
MINIMUM DEGREE OF ACCURACY: Submeter
PROVEN SOURCE OF ELEVATION: WVDOT, Harrisville, WV

STATE OF WEST VIRGINIA
DEPARTMENT OF ENVIRONMENTAL PROTECTION
OIL AND GAS DIVISION

DATE: May 28 20 26
OPERATOR'S WELL NO. Burke Unit 1H

API WELL NO
47 - 095 - 02946
STATE COUNTY PERMIT

WELL TYPE: ☐ OIL ☒ GAS ☐ LIQUID INJECTION ☐ WASTE DISPOSAL
(IF GAS) PRODUCTION : ☐ STORAGE ☐ DEEP ☒ SHALLOW
LOCATION: ELEVATION: As-Built 1,036' WATERSHED: Outlet Middle Island Creek QUADRANGLE: Paden City
DISTRICT: Lincoln COUNTY: Tyler
SURFACE OWNER: Antero Resources Corp ACREAGE: 52.51


09/25/2026

ROYALTY OWNER: Raymond B. Heintzman & Eva J. Heintzman LEASE NO: _____ ACREAGE: 52.51
PROPOSED WORK: ☐ DRILL ☐ CONVERT ☐ DRILL DEEPER ☐ FRACTURE OR STIMULATE ☐ PLUG OFF OLD FORMATION
☐ PERFORATE NEW FORMATION ☒ OTHER PHYSICAL CHANGE IN WELL (SPECIFY) As-Drilled
☐ PLUG AND ABANDON ☐ CLEAN OUT AND REPLUG TARGET FORMATION: Marcellus Shale ESTIMATED DEPTH: 6,101' TVD / 19,161' MD


WELL OPERATOR: Antero Resources Corporation DESIGNATED AGENT: Conrad Baston
ADDRESS: 1615 Wynkoop Street, Denver, CO 80202 ADDRESS: 535 White Oaks Blvd., Bridgeport, WV 26330

Antero Resources
Well No. Burke 1H
As-Drilled
Antero Resources Corporation

Detail 2 (1"=500')

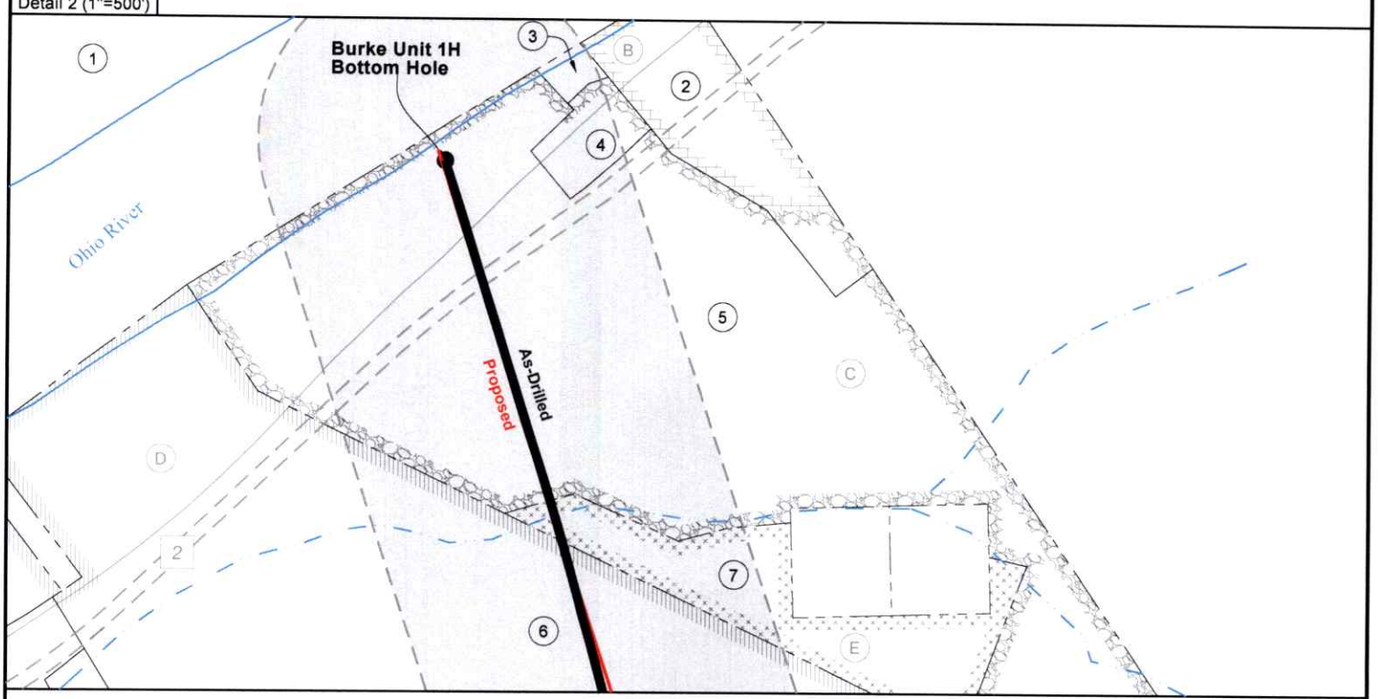

Detail 1 (1"=500')

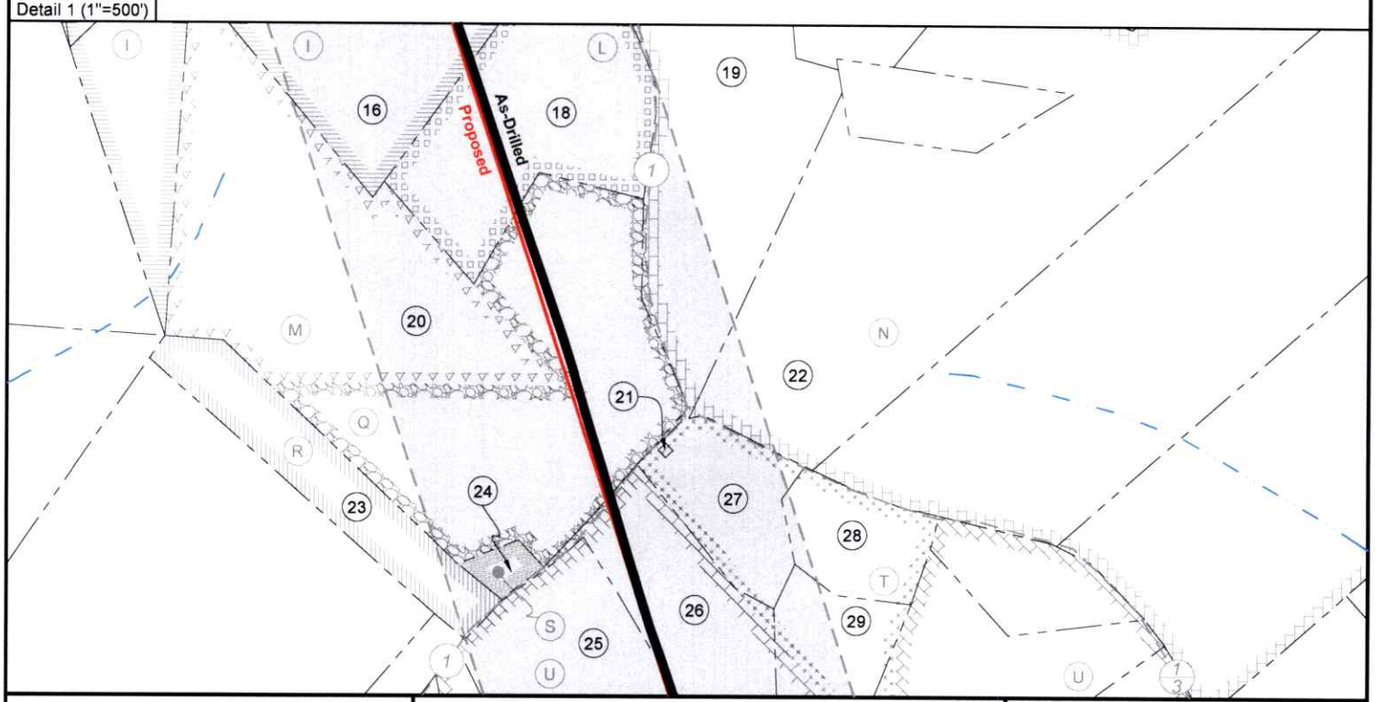

FILE NO: 162-54-L-23
DRAWING NO: Burke Unit 1H As-Drilled
SCALE: 1" = 2000'
MINIMUM DEGREE OF ACCURACY: Submeter
PROVEN SOURCE OF ELEVATION: WVDOT, Harrisville, WV

STATE OF WEST VIRGINIA
DEPARTMENT OF ENVIRONMENTAL PROTECTION
OIL AND GAS DIVISION

DATE: May 28 20 26
OPERATOR'S WELL NO. Burke Unit 1H

API WELL NO
47 - 095 - 02946
STATE COUNTY PERMIT


WELL TYPE: ☐ OIL ☒ GAS ☐ LIQUID INJECTION ☐ WASTE DISPOSAL
(IF GAS) PRODUCTION : ☐ STORAGE ☐ DEEP ☒ SHALLOW
LOCATION: ELEVATION: As-Built 1,036' WATERSHED: Outlet Middle Island Creek QUADRANGLE: Paden City
DISTRICT: Lincoln COUNTY: Tyler
SURFACE OWNER: Antero Resources Corp ACREAGE: 52.51 09/25/2026
ROYALTY OWNER: Raymond B. Heintzman & Eva J. Heintzman LEASE NO: _____ ACREAGE: 52.51
PROPOSED WORK: ☐ DRILL ☐ CONVERT ☐ DRILL DEEPER ☐ FRACTURE OR STIMULATE ☐ PLUG OFF OLD FORMATION
☐ PERFORATE NEW FORMATION ☒ OTHER PHYSICAL CHANGE IN WELL (SPECIFY) As-Drilled
☐ PLUG AND ABANDON ☐ CLEAN OUT AND REPLUG TARGET FORMATION: Marcellus Shale ESTIMATED DEPTH: 6,101' TVD / 19,161' MD

WELL OPERATOR: Antero Resources Corporation DESIGNATED AGENT: Conrad Baston
ADDRESS: 1615 Wynkoop Street ADDRESS: 535 White Oaks Blvd.
Denver, CO 80202 Bridgeport, WV 26330

Antero Resources
Well No. Burke 1H
As-Drilled
Antero Resources Corporation

ID	Lease
B	ATX Mineral Holdings, LLC
C	Betty Jean Reed
D	David E. Bowyer
E	Everett Max Rine
G	BRC Appalachian Minerals I, LLC
H	Greenbrier Royalty Fund II, LLC
I	William J. Patterson, et al
J	William J. Patterson, et al
K	William J. Patterson, et al
L	Master Mineral Holdings II, LP
M	AMFLO Enterprises, LLC
N	Michael D. Eddy
Q	Francis R. Gaiser
R	Jeffrey A. & Karen Jo Gaiser
S	Jack G. Gaiser Revocable Living Trust
T	James Earl Cooper
U	AMP Fund II, LP
V	Waco Oil & Gas Co., Inc.
W	BRC Appalachian Minerals I, LLC
Y	Raymond B. Heintzman & Eva J. Heintzman
Z	BRC Appalachian Minerals I, LLC
AA	Nevin Porter, et al
AC	Virginia A. Nalley
AD	John L. Hess

Wellhead Layout (NTS)

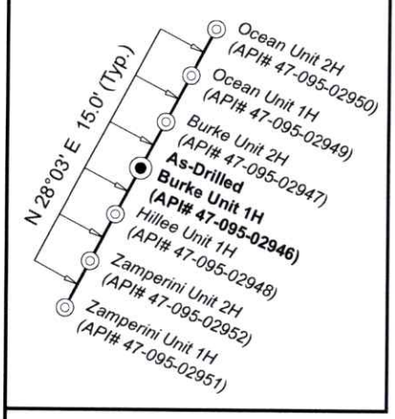

Legend

- Proposed gas well
- Well Reference, as noted
- Monument, as noted
- Existing Well, as noted
- Digitized Well, as noted
- Creek or Drain
- Existing road
- Surface boundary (approx.)
- State line (approx.)

Notes
West Virginia Coordinate System of 1927, North Zone based upon Differential GPS Measurements.
Well No. Burke Unit 1H Top Hole coordinates are
N: 387,127.26' Latitude: 39°33'13.86"
E: 1,591,601.23' Longitude: 80°56'54.41"
Bottom Hole coordinates are
N: 399,558.89' Latitude: 39°35'16.12"
E: 1,587,828.20' Longitude: 80°57'45.16"
UTM Zone 17, NAD 1983
Top Hole Coordinates: N: 4,378,250.723m E: 504,443.853m
Bottom Hole Coordinates: N: 4,382,018.883m E: 503,231.239m
Plat orientation and corner and well references are based upon the grid north meridian.
Well location references are based upon the magnetic meridian.

Top Hole Coordinates, As-drilled data, and information was provided by Antero Resources Corporation. Allegheny Surveys Inc. (ASI) is not certifying the data and information provided. ASI is not responsible for any errors or inaccuracies with the data and information that has been provided.

Notes:
Well No. Burke Unit 1H
As-Drilled POE Coordinates
WV Coordinate System of 1927, North Zone
N: 387,400.72'
E: 1,591,709.39'
Latitude: 39°33'16.58"
Longitude: 80°56'53.08"
UTM Zone 17, NAD 1983
N: 4,378,334.586m
E: 504,475.416m

Tyler County

No.	TM / Par	Owner	Bk / Pg	Ac.
1	1 / 1	United States of America	288 / 119	111.00
2	1 / 5	David & Randi Glendening	625 / 84	4.07
3	1 / 26.1	Larry R. & Kim M. Henthorn	605 / 407	0.37
4	1 / 26	Betty J. Reed	W39 / 498	1.36
5	4 / 53	Ronald A. & Betty J. Reed	214 / 417	51.77
6	4 / 52	Ronald A. & Betty J. Reed	W39 / 384	35.20
7	4 / 53.2	Danny Stewart & Everett M. Rine	323 / 674	7.90
8	4 / 38	Dorothy L. Stewart	562 / 573	59.52
9	4 / 39	Matthew C. & Kelly Stewart	631 / 298	205.17
10	4 / 58	Patrick & Shirley Lancaster	270 / 272	108.48
11	4 / 36	Danny G. & Dorothy L. Stewart	312 / 121	1.46
12	4 / 37	Dorothy Stewart	563 / 318	64.56
13	4 / 34	Dorothy L. Stewart (LE)	562 / 573	64.56
14	4 / 35	Dorothy Stewart	W17 / 50	4.00
15	4 / 30	Daniel C. & Nicki D. Stewart	547 / 140	9.00
16	4 / 33	Joyce A. Owen	W86 / 407	42.00
17	4 / 85	Patrick & Shirley A. Lancaster	212 / 376	86.22
18	4 / 29	Michael D. Eddy	OR 210 / 344	9.60
19	4 / 28	Janice M. & Michael D. Eddy	OR 188 / 546	15.40
20	4 / 27	Frances R. Gaiser	W23 / 29	31.50
21	4 / 98	Friendly Public Service District	320 / 335	0.02
22	4 / 86	Janice M. & Michael D. Eddy	OR 188 / 546	29.12
23	4 / 25	The Jack G. Gaiser Revocable Trust, dated December 30, 2015, et al	OR 312 / 451	5.16
24	4 / 26	The Jack G. Gaiser Revocable Trust, dated December 30, 2015, et al	OR 312 / 451	0.47
25	4 / 103	Trad A. Dill	594 / 323	17.04
26	4 / 105	Danny G. & Susan M. Gilbert	402 / 202	5.79
27	4 / 100	David & Patricia Willey	OR 350 / 627	3.29
28	4 / 101	Jessie L. & Angela S. Sandy	376 / 648	2.61
29	4 / 106	Frank Brogden, et al	593 / 315	14.68
30	4 / 107	Bruce M. Edmonds	349 / 334	11.61
31	8 / 11.2	Frank & Sherry Brogden	367 / 657	14.82
32	4 / 102	Elizabeth A. Davis	331 / 465	6.42
33	8 / 7.3	Michael P. Wells	OR 291 / 170	63.00
34	8 / 10	Camille Mace	418 / 768	32.47
35	8 / 10.2	Curtis & Sarah Tallman	418 / 774	20.04
36	8 / 11	Robert T. Stevenson	357 / 190	27.05
37	8 / 11.1	Camille Mace	418 / 768	7.18
38	8 / 21	Clay W. & Delphine E. Shinn	OR 61 / 786	35.51
39	8 / 10.1	Curtis & Sarah Tallman	418 / 772	6.99
40	8 / 19	Olive Branch Animal Rescue & Refuge, Inc.	OR 312 / 564	173.48
41	8 / 39	Antero Midstream, LLC	OR 218 / 520	70.65
42	8 / 41	David E. & Ila G. Kyle	272 / 189	118.10
43	8 / 21.2	Antero Resources Corp.	OR 296 / 494	52.51

FILE NO: 162-54-L-23
DRAWING NO: Burke Unit 1H As-Drilled
SCALE: 1" = 2000'
MINIMUM DEGREE OF ACCURACY: Submeter
PROVEN SOURCE OF ELEVATION: WVDOT, Harrisville, WV

STATE OF WEST VIRGINIA
DEPARTMENT OF ENVIRONMENTAL PROTECTION
OIL AND GAS DIVISION

DATE: May 28 20 26
OPERATOR'S WELL NO. Burke Unit 1H

API WELL NO
47 - 095 - 02946
STATE COUNTY PERMIT

WELL TYPE: ☐ OIL ☒ GAS ☐ LIQUID INJECTION ☐ WASTE DISPOSAL
(IF GAS) PRODUCTION : ☐ STORAGE ☐ DEEP ☒ SHALLOW
LOCATION: ELEVATION: As-Built 1,036' WATERSHED: Outlet Middle Island Creek QUADRANGLE: Paden City
DISTRICT: Lincoln COUNTY: Tyler
SURFACE OWNER: Antero Resources Corp ACREAGE: 52.51
09/25/2026
ROYALTY OWNER: Raymond B. Heintzman & Eva J. Heintzman LEASE NO: _____ ACREAGE: 52.51
PROPOSED WORK: ☐ DRILL ☐ CONVERT ☐ DRILL DEEPER ☐ FRACTURE OR STIMULATE ☐ PLUG OFF OLD FORMATION
☐ PERFORATE NEW FORMATION ☒ OTHER PHYSICAL CHANGE IN WELL (SPECIFY) As-Drilled
☐ PLUG AND ABANDON ☐ CLEAN OUT AND REPLUG TARGET FORMATION: Marcellus Shale ESTIMATED DEPTH: 6,101' TVD / 19,161' MD

WELL OPERATOR: Antero Resources Corporation DESIGNATED AGENT: Conrad Baston
ADDRESS: 1615 Wynkoop Street, Denver, CO 80202 ADDRESS: 535 White Oaks Blvd., Bridgeport, WV 26330