
Antero Resources
Well No. Hillee 1H
As-Drilled
Antero Resources Corporation

Page 1 of 2

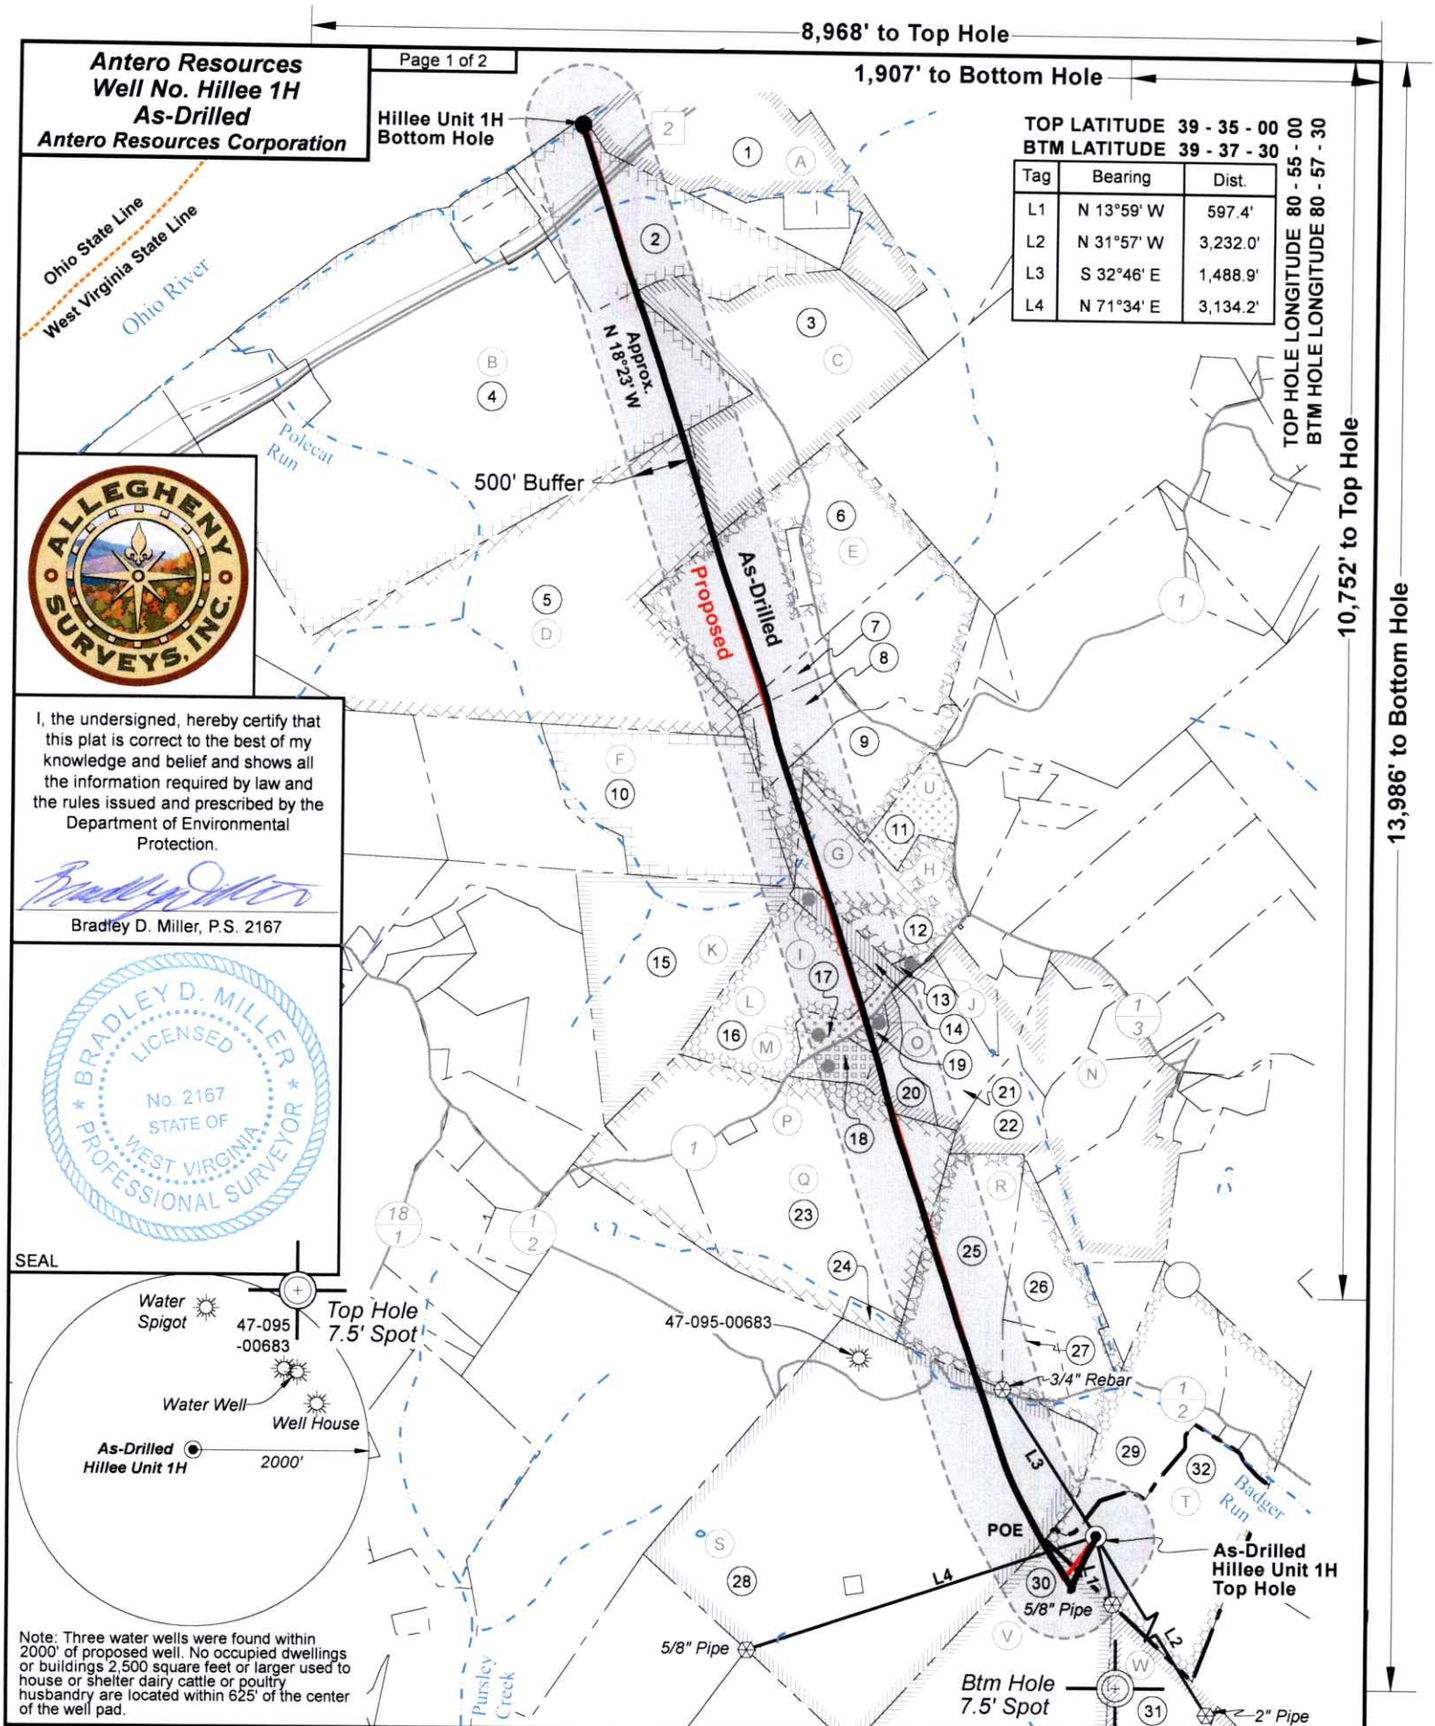

Tag	Bearing	Dist.
L1	N 13°59' W	597.4'
L2	N 31°57' W	3,232.0'
L3	S 32°46' E	1,488.9'
L4	N 71°34' E	3,134.2'

ALLEGHENY SURVEYS, INC.

I, the undersigned, hereby certify that this plat is correct to the best of my knowledge and belief and shows all the information required by law and the rules issued and prescribed by the Department of Environmental Protection.

Bradley D. Miller, P.S. 2167

BRADLEY D. MILLER LICENSED No. 2167 STATE OF WEST VIRGINIA PROFESSIONAL SURVEYOR

SEAL

Note: Three water wells were found within 2000' of proposed well. No occupied dwellings or buildings 2,500 square feet or larger used to house or shelter dairy cattle or poultry husbandry are located within 625' of the center of the well pad.

FILE NO: 253-54-L-14
DRAWING NO: Hillee Unit 1H As-Drilled
SCALE: 1" = 1500'
MINIMUM DEGREE OF ACCURACY: Submeter
PROVEN SOURCE OF ELEVATION: WVDOT, Harrisville, WV

STATE OF WEST VIRGINIA
DEPARTMENT OF ENVIRONMENTAL PROTECTION
OIL AND GAS DIVISION

DATE: May 28 20 26
OPERATOR'S WELL NO. Hillee Unit 1H

API WELL NO
47 - 095 - 02948
STATE COUNTY PERMIT


WELL TYPE: ☐ OIL ☒ GAS ☐ LIQUID INJECTION ☐ WASTE DISPOSAL
(IF GAS) PRODUCTION : ☐ STORAGE ☐ DEEP ☒ SHALLOW
LOCATION: ELEVATION: As-Built 1,036' WATERSHED: Outlet Middle Island Creek QUADRANGLE: Paden City
DISTRICT: Lincoln COUNTY: Tyler
SURFACE OWNER: Antero Resources Corp ACREAGE: 52.51
09/25/2026
ROYALTY OWNER: Raymond B. Heintzman & Eva J. Heintzman LEASE NO: _____ ACREAGE: 52.51
PROPOSED WORK: ☐ DRILL ☐ CONVERT ☐ DRILL DEEPER ☐ FRACTURE OR STIMULATE ☐ PLUG OFF OLD FORMATION
☐ PERFORATE NEW FORMATION ☒ OTHER PHYSICAL CHANGE IN WELL (SPECIFY) As-Drilled
☐ PLUG AND ABANDON ☐ CLEAN OUT AND REPLUG TARGET FORMATION: Marcellus Shale ESTIMATED DEPTH: 6,042' TVD 19,081' MD

WELL OPERATOR: Antero Resources Corporation DESIGNATED AGENT: Conrad Baston
ADDRESS: 1615 Wynkoop Street ADDRESS: 535 White Oaks Blvd.
Denver, CO 80202 Bridgeport, WV 26330

Antero Resources
Well No. Hillee 1H
As-Drilled
Antero Resources Corporation

Page 2 of 2

Wellhead Layout (NTS)

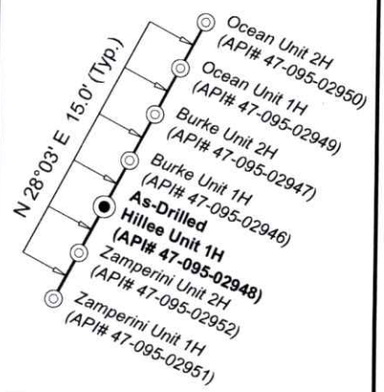

ID	Lease
A	Betty Jean Reed
B	David E. Bowyer
C	BRC Appalachian Minerals I, LLC
D	Sara Anetsberger
E	William J. Patterson, et al
F	Greenbrier Royalty Fund II, LLC
G	AMFLO Enterprises, LLC
H	Francis R. Gaiser
I	Jeffery A. & Karen Jo Gaiser
J	Jack G. Gaiser Revocable Living Trust
K	Happy Endings, LLC
L	Jeffery A. & Karen Jo Gaiser
M	Jeffery A. & Karen Jo Gaiser
N	AMP Fund II, LP
O	Elizabeth A. Davis
P	James F. Lucas
Q	Waco Oil & Gas Co., Inc.
R	BRC Appalachian Minerals I, LLC
S	Nevin Porter, et al
T	Raymond B. Heintzman & Eva J. Heintzman
U	Master Mineral Holdings II, LP
V	Virginia A. Nalley
W	John L. Hess

Legend

- Proposed gas well
- Well Reference, as noted
- Monument, as noted
- Existing Well, as noted
- Digitized Well, as noted
- Creek or Drain
- Existing road
- Surface boundary (approx.)
- State line (approx.)

Tyler County

No.	TM / Par	Owner	Bk / Pg	Ac.
1	4 / 53	Ronald A. & Betty J. Reed	214 / 417	51.77
2	4 / 52	Ronald A. & Betty J. Reed	W39 / 384	35.20
3	4 / 38	Dorothy L. Stewart	562 / 573	59.52
4	4 / 39	Matthew C. & Kelly Stewart	631 / 298	205.17
5	4 / 44	William H. McCoy	OR 65 / 450	221.66
6	4 / 37	Dorothy Stewart	563 / 318	64.56
7	4 / 35	Dorothy Stewart	W17 / 50	4.00
8	4 / 30	Daniel C. & Nicki D. Stewart	547 / 140	9.00
9	4 / 33	Joyce A. Owen	W86 / 407	42.00
10	4 / 23	Karen A. Pachuta & Karl J. Varone	340 / 269	47.50
11	4 / 29	Michael D. Eddy	OR 210 / 344	9.60
12	4 / 27	Frances R. Gaiser	W23 / 29	31.50
13	4 / 26	The Jack G. Gaiser Revocable Trust, dated December 30, 2015, et al	OR 312 / 451	0.47
14	4 / 25	The Jack G. Gaiser Revocable Trust, dated December 30, 2015, et al	OR 312 / 451	5.16
15	4 / 22	The Jack G. Gaiser Revocable Trust, dated December 30, 2015, et al	OR 312 / 451	49.70
16	4 / 93	Jeffrey A. Gaiser, et ux, et al	258 / 450	41.55
17	4 / 93.1	Jeffrey A. & Karen J. Gaiser	281 / 444	4.20
18	4 / 94	James F. Lucas	OR 120 / 463	4.09
19	4 / 24	Elizabeth A. Davis	OR 55 / 58	1.47
20	4 / 102	Elizabeth A. Davis	331 / 465	6.42
21	4 / 103	Trad A. Dill	594 / 323	17.04
22	4 / 106	Frank Brogden, et al	593 / 315	14.68
23	8 / 7.3	Michael P. Wells	OR 291 / 170	63.00
24	8 / 7.1	Jeffrey S. Moore	230 / 764	2.00
25	8 / 10	Camille Mace	418 / 768	32.47
26	8 / 10.2	Curtis & Sarah Tallman	418 / 774	20.04
27	8 / 10.1	Curtis & Sarah Tallman	418 / 772	6.99
28	8 / 19	Olive Branch Animal Rescue & Refuge, Inc.	OR 312 / 564	173.48
29	8 / 21	Clay W. & Delphine E. Shinn	OR 61 / 786	35.51
30	8 / 39	Antero Midstream, LLC	OR 218 / 520	70.65
31	8 / 41	David E. & Ila G. Kyle	272 / 189	118.10
32	8 / 21.2	Antero Resources Corp.	OR 296 / 494	52.51

Top Hole Coordinates, As-drilled data, and information was provided by Antero Resources Corporation. Allegheny Surveys Inc. (ASI) is not certifying the data and information provided. ASI is not responsible for any errors or inaccuracies with the data and information that has been provided.

Notes:
Well No. Hillie Unit 1H
As-Drilled POE Coordinates
WV Coordinate System of 1927, North Zone
N: 387,188.01'
E: 1,591,070.69'
Latitude: 39°33'14.38"
Longitude: 80°57'01.19"
UTM Zone 17, NAD 1983
N: 4,378,266.528m
E: 504,281.913m

Notes
West Virginia Coordinate System of 1927, North Zone
based upon Differential GPS Measurements.
Well No. Hillee Unit 1H Top Hole coordinates are
N: 387,114.05' Latitude: 39°33'13.73"
E: 1,591,594.11' Longitude: 80°56'54.50"
Bottom Hole coordinates are
N: 399,130.81' Latitude: 39°35'11.77"
E: 1,587,100.99' Longitude: 80°57'54.35"
UTM Zone 17, NAD 1983
Top Hole Coordinates: N: 4,378,246.663m E: 504,441.751m
Bottom Hole Coordinates: N: 4,381,884.761m E: 503,011.865m
Plat orientation and corner and well references are based upon the grid north meridian.
Well location references are based upon the magnetic meridian.

FILE NO: 253-54-L-14
DRAWING NO: Hillee Unit 1H As-Drilled
SCALE: 1" = 1500'
MINIMUM DEGREE OF ACCURACY: Submeter
PROVEN SOURCE OF ELEVATION: WVDOT, Harrisville, WV

STATE OF WEST VIRGINIA
DEPARTMENT OF ENVIRONMENTAL PROTECTION
OIL AND GAS DIVISION

DATE: May 28 20 26
OPERATOR'S WELL NO. Hillee Unit 1H

API WELL NO
47 - 095 - 02948
STATE COUNTY PERMIT

WELL TYPE: ☐ OIL ☒ GAS ☐ LIQUID INJECTION ☐ WASTE DISPOSAL
(IF GAS) PRODUCTION : ☐ STORAGE ☐ DEEP ☒ SHALLOW
LOCATION: ELEVATION: As-Built 1,036' WATERSHED: Outlet Middle Island Creek QUADRANGLE: Paden City
DISTRICT: Lincoln COUNTY: Tyler
SURFACE OWNER: Antero Resources Corp ACREAGE: 52.51
09/25/2026
ROYALTY OWNER: Raymond B. Heintzman & Eva J. Heintzman LEASE NO: _____ ACREAGE: 52.51
PROPOSED WORK: ☐ DRILL ☐ CONVERT ☐ DRILL DEEPER ☐ FRACTURE OR STIMULATE ☐ PLUG OFF OLD FORMATION
☐ PERFORATE NEW FORMATION ☒ OTHER PHYSICAL CHANGE IN WELL (SPECIFY) As-Drilled
☐ PLUG AND ABANDON ☐ CLEAN OUT AND REPLUG TARGET FORMATION: Marcellus Shale ESTIMATED DEPTH: 6,042' TVD 19,081' MD

WELL OPERATOR: Antero Resources Corporation
ADDRESS: 1615 Wynkoop Street, Denver, CO 80202
DESIGNATED AGENT: Conrad Baston
ADDRESS: 535 White Oaks Blvd., Bridgeport, WV 26330