Antero Resources
Well No. Ocean 1H
As-Drilled
Antero Resources Corporation

Page 1 of 2

11,519' to Bottom Hole

8,952' to Top Hole

BHL LATITUDE 39 - 37 - 30
THL LATITUDE 39 - 35 - 00

LONGITUDE 80 - 55 - 00

10,712' to Top Hole

12,647' to Bottom Hole

	Bearing	Dist.
L1	N 11°15' W	631.5'
L2	N 31°16' W	3,254.7'
L3	S 34°17' E	1,467.4'
L4	N 71°00' E	3,166.9'

Top Hole Coordinates, As-drilled data, and information was provided by Antero Resources Corporation. Allegheny Surveys Inc. (ASI) is not certifying the data and information provided. ASI is not responsible for any errors or inaccuracies with the data and information that has been provided.

ALLEGHENY SURVEYS, INC.

Legend

- Proposed gas well
- Monument, as noted
- Existing Well, as noted
- Digitized Well, as noted
- Creek or Drain
- Road
- Surface boundary (approx.)
- Interior surface tracts (approx.)

I, the undersigned, hereby certify that this plat is correct to the best of my knowledge and belief and shows all the information required by law and the rules issued and prescribed by the Department of Environmental Protection.


Bradley D. Miller, P.S. 2167

BRADLEY D. MILLER LICENSED No. 2167 STATE OF WEST VIRGINIA PROFESSIONAL SURVEYOR

SEAL

Notes
West Virginia Coordinate System of 1927, North Zone
based upon Differential GPS Measurements.
Well No. Ocean Unit 1H Top Hole coordinates are
N: 387,153.76' Latitude: 39°33'14.13"
E: 1,591,615.58' Longitude: 80°56'54.23"
Bottom Hole coordinates are
N: 400,434.94' Latitude: 39°35'25.00"
E: 1,589,252.92' Longitude: 80°57'27.14"
UTM Zone 17, NAD 1983
Top Hole Coordinates Bottom Hole Coordinates
N: 4,378,258.870m N: 4,382,293.037m
E: 504,448.090m E: 503,660.839m
Plat orientation and corner and well references are based upon the grid north meridian.
Well location references are based upon the magnetic meridian.

Notes:
Well No. Ocean Unit 1H
As-Drilled POE Coordinates
WV Coordinate System of 1927, North Zone
N: 387,937.48'
E: 1,593,246.25'
Latitude: 39°33'22.13"
Longitude: 80°56'33.57"
UTM Zone 17, NAD 1983
N: 4,378,505.944m
E: 504,940.902m

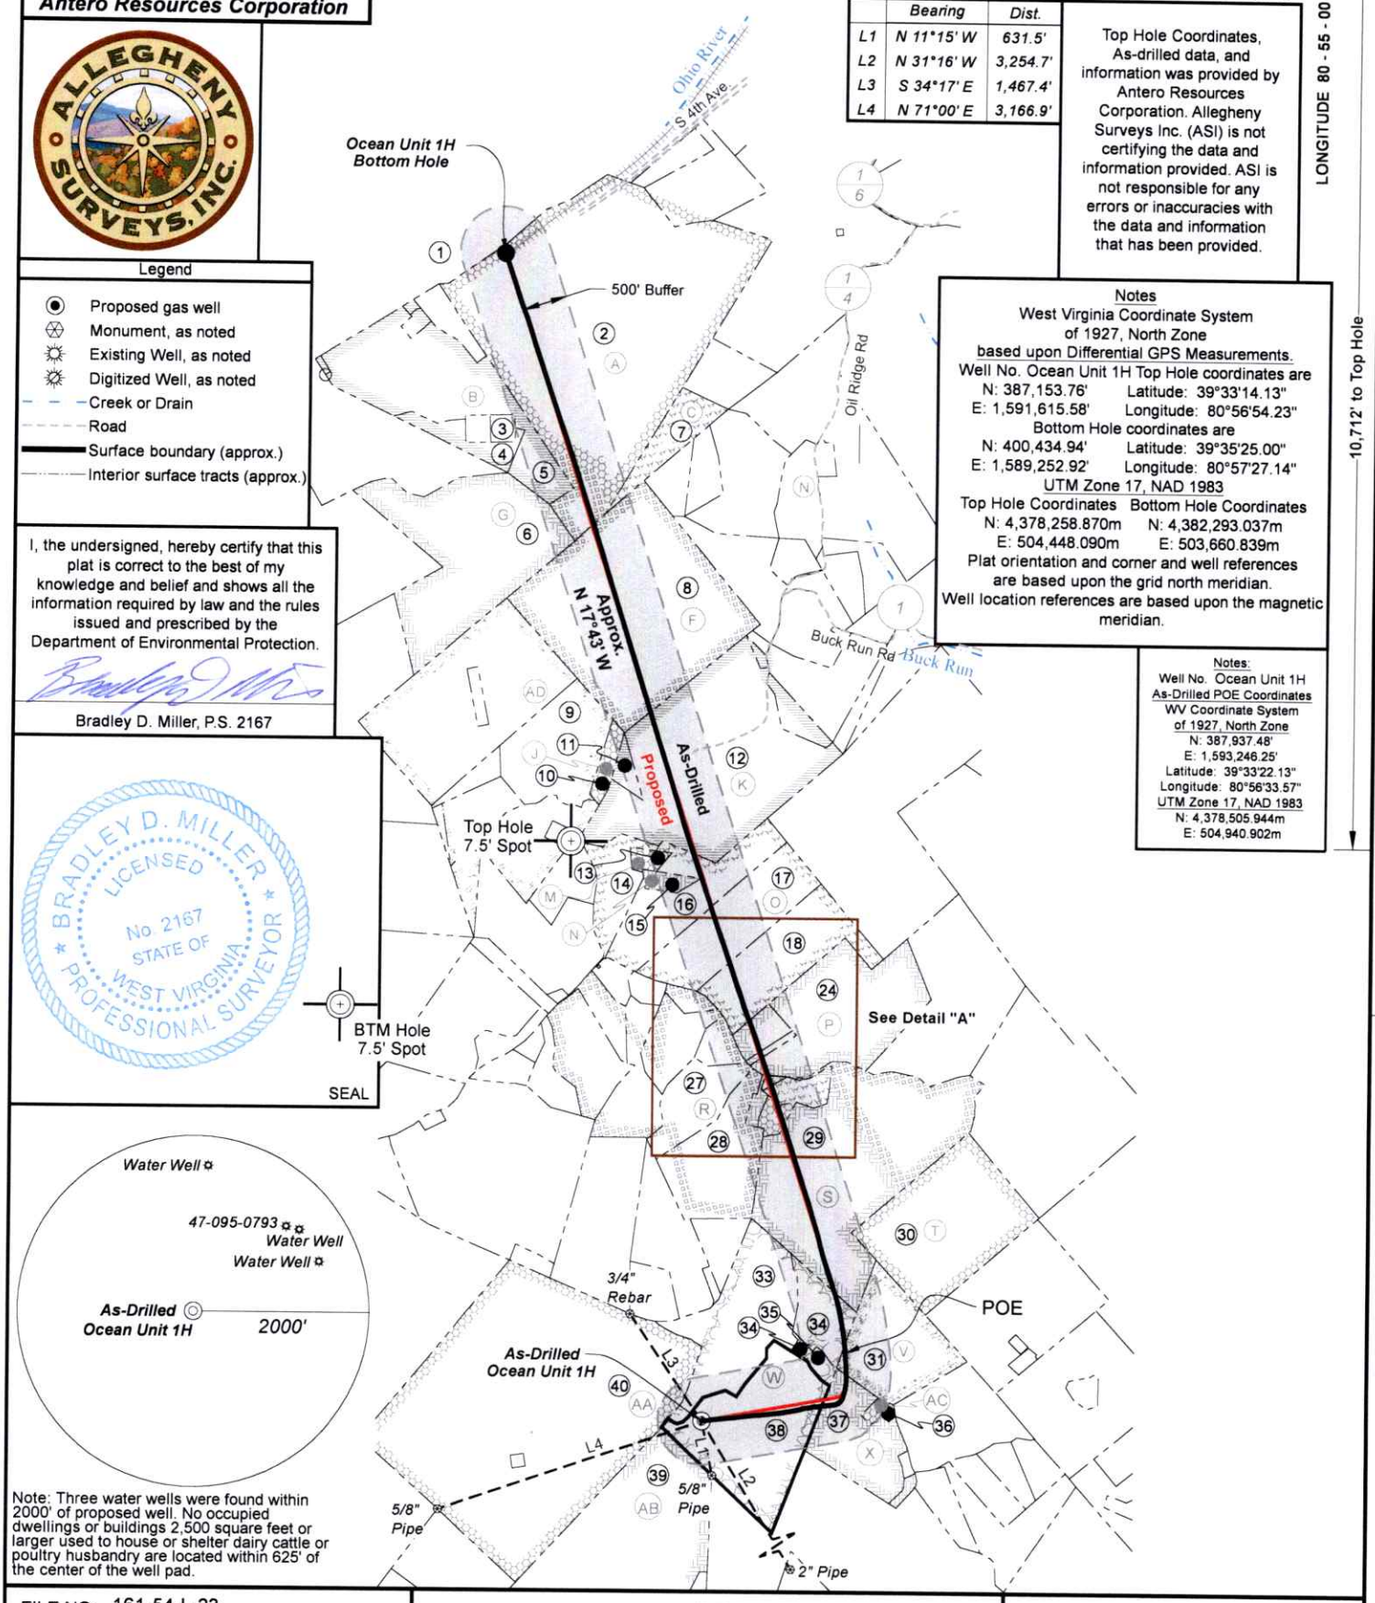

Note: Three water wells were found within 2000' of proposed well. No occupied dwellings or buildings 2,500 square feet or larger used to house or shelter dairy cattle or poultry husbandry are located within 625' of the center of the well pad.

FILE NO: 161-54-L-23
DRAWING NO: Ocean Unit 1H As-Drilled
SCALE: 1" = 2000'
MINIMUM DEGREE OF ACCURACY: Submeter
PROVEN SOURCE OF ELEVATION: WVDOT, Harrisville, WV

STATE OF WEST VIRGINIA
DEPARTMENT OF ENVIRONMENTAL PROTECTION
OIL AND GAS DIVISION

DATE: May 28 20 26
OPERATOR'S WELL NO. Ocean Unit 1H

API WELL NO
47 - 095 - 02949
STATE COUNTY PERMIT


WELL TYPE: ☐ OIL ☒ GAS ☐ LIQUID INJECTION ☐ WASTE DISPOSAL
(IF GAS) PRODUCTION : ☐ STORAGE ☐ DEEP ☒ SHALLOW
LOCATION: ELEVATION: As-Built 1,036' WATERSHED: Outlet Middle Island Creek QUADRANGLE: Paden City
DISTRICT: Lincoln COUNTY: Tyler
SURFACE OWNER: Antero Resources Corp ACREAGE: 52.51 09/25/2026
ROYALTY OWNER: Raymond B. Heintzman & Eva J. Heintzman LEASE NO: _____ ACREAGE: 52.51
PROPOSED WORK: ☐ DRILL ☐ CONVERT ☐ DRILL DEEPER ☐ FRACTURE OR STIMULATE ☐ PLUG OFF OLD FORMATION
☐ PERFORATE NEW FORMATION ☒ OTHER PHYSICAL CHANGE IN WELL (SPECIFY) As-Drilled
☐ PLUG AND ABANDON ☐ CLEAN OUT AND REPLUG TARGET FORMATION: Marcellus Shale ESTIMATED DEPTH: 6,086' TVD 19,825' MD


WELL OPERATOR: Antero Resources Corporation DESIGNATED AGENT: Conrad Baston
ADDRESS: 1615 Wynkoop Street ADDRESS: 535 White Oaks Blvd.
Denver, CO 80202 Bridgeport, WV 26330

Antero Resources
Well No. Ocean 1H
As-Drilled
Antero Resources Corporation

	Leases
A	Golden Eagle Resources II, LLC
B	Betty Jean Reed
C	Michael J. Hough
F	Greenbrier Royalty Fund II, LLC
G	BRC Appalachian Minerals I, LLC
J	William J. Patterson, et al
K	William J. Patterson, et al
M	Joshua D. Beaty & Michelle E. Beaty
N	Michael D. Eddy
O	Michael D. Eddy
P	Shirley Myers
R	AMP Fund II, LP
S	BRC Appalachian Minerals I, LLC
T	Bounty Minerals, LLC
V	Drilling Appalachian Corporation
W	Raymond B. Heintzman & Eva J. Heintzman
X	Bounty Minerals, LLC
AA	Nevin Porter, et al
AB	Virginia A. Nalley
AC	Michael V. Smith
AD	William J. Patterson, et al

ID	TM-Par	Owner	Bk/Pg	Acres
2	1-4	Haessly Hardwood Lumber Company	290/457	166.20
3	4-55	Bertha & Carl Wise	150/481	2.00
4	4-53.2	Danny G. Stewart & Everet M. Rine	323/674	7.90
5	4-53	Betty J. Reed	WB39/498	51.77
6	4-38	Dorthy Stewart	562/573	59.54
7	4-57	Michael J. Hough & Linda L. Anderson	OR19/795	11.64
8	4-58	Patrick & Shirley Lancaster	270/272	108.00
9	4-34	Dorthy Stewart	562/573	20.00
10	4-32	William J. Cooper	315/593	2.00
11	4-31	William Joseph Cooper	203/256	3.00
12	4-85	Patrick & Shirley A. Lancaster	212/376	86.22
13	4-28.1	Mike Eddy	344/226	2.10
14	4-28	Janice M. Eddy	188/546	13.64
15	4-86.1	Mike Eddy	344/226	2.51
16	4-86	Janice M. & Michael D. Eddy	188/546	28.63
17	4-87	Janice M. & Michael D. Eddy	188/546	30.24
18	4-88	Janice M. & Michael D. Eddy	188/546	30.10
19	4-89	Joyce A. Bassett	333/511	2.57
20	4-107	Bruce M. Edmonds	349/334	11.61
21	4-99	Frank W. & Sherry L. Brogden	332/105	4.50
22	4-90	William J. Grasso	284/609	5.01
23	4-90.2	William J. Grasso	284/609	1.00
24	4-90.1	Gary B. & Melinda J. Lewis	473/1	47.33
25	4-96	James D. Buck	404/633	5.03
26	4-97	Donna Kathy Johnston	184/133	3.44
27	8-11.2	Frank & Sherry Brogden	367/657	14.18
28	8-11	Robert Travis Stevenson	357/190	27.05
29	8-12	Grayce Louise Buck	144/482	86.89
30	8-13	Donna Kathy Johnston	184/133	50.00
31	8-23	Elden Jackson & Jennifer Lynn Wryosdick	385/343	30.00
32	8-21.1	Justin P. & Stephanie M. Richards	411/189	11.24
33	8-21	Antero Resources Corp	296/490	35.51
34	8-21.3	Adam Nathaniel Wayne	236/556	0.78
35	8-21.4	Jodie E. Michael	373/544	1.78
36	8-22.2	Michael V. Smith	219/609	1.44
37	8-22	David E. & Ila Grace Kyle	270/206	24.63
38	8-21.2	Antero Resources Corp	296/494	52.51
39	8-39	Virginia A. Nalley	218/520	70.65
40	8-19	Olive Branch Animal Rescue & Refuge, Inc	333/804	173.48

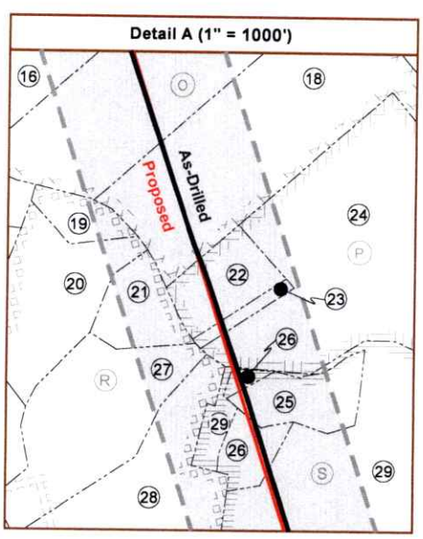

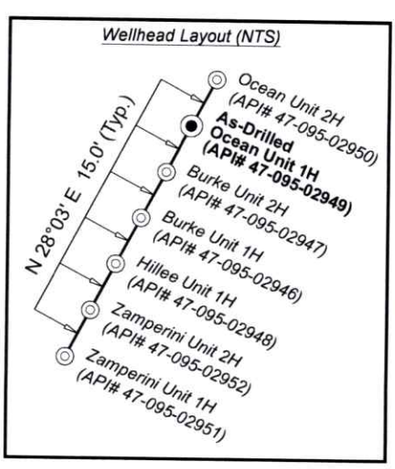

FILE NO: 161-54-L-23
DRAWING NO: Ocean Unit 1H As-Drilled
SCALE: 1" = 2000'
MINIMUM DEGREE OF ACCURACY: Submeter
PROVEN SOURCE OF ELEVATION: WVDOT, Harrisville, WV

STATE OF WEST VIRGINIA
DEPARTMENT OF ENVIRONMENTAL PROTECTION
OIL AND GAS DIVISION

DATE: May 28 20 26
OPERATOR'S WELL NO. Ocean Unit 1H
API WELL NO
47 - 095 - 02949
STATE COUNTY PERMIT

WELL TYPE: ☐ OIL ☒ GAS ☐ LIQUID INJECTION ☐ WASTE DISPOSAL
(IF GAS) PRODUCTION : ☐ STORAGE ☐ DEEP ☒ SHALLOW
LOCATION: ELEVATION: As-Built 1,036' WATERSHED: Outlet Middle Island Creek QUADRANGLE: Paden City
DISTRICT: Lincoln COUNTY: Tyler
SURFACE OWNER: Antero Resources Corp ACREAGE: 52.51
09/25/2026
ROYALTY OWNER: Raymond B. Heintzman & Eva J. Heintzman LEASE NO: _____ ACREAGE: 52.51
PROPOSED WORK: ☐ DRILL ☐ CONVERT ☐ DRILL DEEPER ☐ FRACTURE OR STIMULATE ☐ PLUG OFF OLD FORMATION
☐ PERFORATE NEW FORMATION ☒ OTHER PHYSICAL CHANGE IN WELL (SPECIFY) As-Drilled
☐ PLUG AND ABANDON ☐ CLEAN OUT AND REPLUG TARGET FORMATION: Marcellus Shale ESTIMATED DEPTH: 6,086' TVD 19,825' MD

WELL OPERATOR: Antero Resources Corporation DESIGNATED AGENT: Conrad Baston
ADDRESS: 1615 Wynkoop Street ADDRESS: 535 White Oaks Blvd.
Denver, CO 80202 Bridgeport, WV 26330