Antero Resources
Well No. Ocean 2H
As-Drilled
Antero Resources Corporation

Page 1 of 2

10,792' to Bottom Hole

8,941' to Top Hole

BHL LATITUDE 39 - 37 - 30
THL LATITUDE 39 - 35 - 00

LONGITUDE 80 - 55 - 00

10,699' to Top Hole

12,066' to Bottom Hole

	Bearing	Dist.
L1	N 10°24' W	643.2'
L2	N 31°02' W	3,262.4'
L3	S 34°49' E	1,460.5'
L4	N 70°49' E	3,178.0'

Top Hole Coordinates, As-drilled data, and information was provided by Antero Resources Corporation. Allegheny Surveys Inc. (ASI) is not certifying the data and information provided. ASI is not responsible for any errors or inaccuracies with the data and information that has been provided.

Legend

- Proposed gas well
- Monument, as noted
- Existing Well, as noted
- Digitized Well, as noted
- Creek or Drain
- Road
- Surface boundary (approx.)
- Interior surface tracts (approx.)

Notes

West Virginia Coordinate System of 1927, North Zone based upon Differential GPS Measurements.
Well No. Ocean Unit 2H Top Hole coordinates are
N: 387,166.83' Latitude: 39°33'14.26"
E: 1,591,622.30' Longitude: 80°56'54.15"
Bottom Hole coordinates are
N: 401,003.64' Latitude: 39°35'30.74"
E: 1,589,988.44' Longitude: 80°57'17.86"
UTM Zone 17, NAD 1983
Top Hole Coordinates: N: 4,378,262.886m E: 504,450.071m
Bottom Hole Coordinates: N: 4,382,470.043m E: 503,882.031m
Plat orientation and corner and well references are based upon the grid north meridian.
Well location references are based upon the magnetic meridian.

Notes:
Well No. Ocean Unit 2H
As-Drilled POE Coordinates
WV Coordinate System of 1927, North Zone
N: 388,226.16'
E: 1,594,026.49'
Latitude: 39°33'25.11"
Longitude: 80°56'23.67"
UTM Zone 17, NAD 1983
N: 4,378,597.867m
E: 505,177.140m

I, the undersigned, hereby certify that this plat is correct to the best of my knowledge and belief and shows all the information required by law and the rules issued and prescribed by the Department of Environmental Protection.

Bradley D. Miller, P.S. 2167

BRADLEY D. MILLER LICENSED No. 2167 STATE OF WEST VIRGINIA PROFESSIONAL SURVEYOR

SEAL

Ocean Unit 2H Bottom Hole
Ohio River
S 4th Ave
500' Buffer
Proposed As-Drilled
Approx. N 17°32' W
Oil Ridge Rd
Buck Run Rd
Buck Run
Top Hole 7.5' Spot
BTM Hole 7.5' Spot
See Detail "A"
POE
3/4" Rebar
As-Drilled Ocean Unit 2H
5/8" Pipe
5/8" Pipe
2" Pipe

Water Well
47-095-0793 Water Well
Water Well
As-Drilled Ocean Unit 2H
2000'

Note: Three water wells were found within 2000' of proposed well. No occupied dwellings or buildings 2,500 square feet or larger used to house or shelter dairy cattle or poultry husbandry are located within 625' of the center of the well pad.

FILE NO: 161-54-L-23
DRAWING NO: Ocean Unit 2H As-Drilled
SCALE: 1" = 2000'
MINIMUM DEGREE OF ACCURACY: Submeter
PROVEN SOURCE OF ELEVATION: WVDOT, Harrisville, WV

STATE OF WEST VIRGINIA
DEPARTMENT OF ENVIRONMENTAL PROTECTION
OIL AND GAS DIVISION

DATE: May 28 20 26
OPERATOR'S WELL NO. Ocean Unit 2H

API WELL NO
47 - 095 - 02950
STATE COUNTY PERMIT


WELL TYPE: ☐ OIL ☒ GAS ☐ LIQUID INJECTION ☐ WASTE DISPOSAL
(IF GAS) PRODUCTION : ☐ STORAGE ☐ DEEP ☒ SHALLOW
LOCATION: ELEVATION: As-Built 1,036' WATERSHED: Outlet Middle Island Creek QUADRANGLE: Paden City
DISTRICT: Lincoln COUNTY: Tyler
SURFACE OWNER: Antero Resources Corp ACREAGE: 52.51 09/25/2026
ROYALTY OWNER: Raymond B. Heintzman & Eva J. Heintzman LEASE NO: _____ ACREAGE: 52.51
PROPOSED WORK: ☐ DRILL ☐ CONVERT ☐ DRILL DEEPER ☐ FRACTURE OR STIMULATE ☐ PLUG OFF OLD FORMATION
☐ PERFORATE NEW FORMATION ☒ OTHER PHYSICAL CHANGE IN WELL (SPECIFY) As-Drilled
☐ PLUG AND ABANDON ☐ CLEAN OUT AND REPLUG TARGET FORMATION: Marcellus Shale ESTIMATED DEPTH: 6,140' TVD 20,372' MD


WELL OPERATOR: Antero Resources Corporation
ADDRESS: 1615 Wynkoop Street, Denver, CO 80202
DESIGNATED AGENT: Conrad Baston
ADDRESS: 535 White Oaks Blvd., Bridgeport, WV 26330

Antero Resources
Well No. Ocean 2H
As-Drilled
Antero Resources Corporation

	Leases
A	Golden Eagle Resources II, LLC
C	Michael J. Hough
D	John Stanley Starkey
E	Antero Minerals, LLC
F	Greenbrier Royalty Fund II, LLC
H	OCTO Energy, LLC
I	Virgil E. Cooper, et al
K	William J. Patterson, et al
L	John Lewis Renner, II
O	Michael D. Eddy
P	Shirley Myers
Q	Moore Self Storage, North Carolina, LLC
S	BRC Appalachian Minerals I, LLC
T	Bounty Minerals, LLC
U	Theresa J. Drain
V	Drilling Appalachian Corporation
W	Raymond B. Heintzman & Eva J. Heintzman
X	Bounty Minerals, LLC
AA	Nevin Porter, et al
AB	Virginia A. Nalley
AC	Michael V. Smith
AE	M. Sharon Deaton

ID	TM-Par	Owner	Bk/Pg	Acres
2	1-4	Haessly Hardwood Lumber Company	290/457	166.20
3	4-57	Michael J. Hough & Linda L. Anderson	OR19/795	11.64
4	4-59	Jason & Lindsey Snider	395/344	7.00
5	4-60	Jason W. & Lindsey S. Snider	OR19/232	7.00
6	4-61	Otis & Betty Ruth Workman Est	133/175	18.81
7	4-82.4	Virgil E. & Barbra J. Cooper Life Estate	251/278	13.00
8	4-58	Patrick & Shirley Lancaster	270/272	108.00
9	4-85	Patrick & Shirley A. Lancaster	212/376	86.22
10	4-82	Virgil E. & Barbra J. Cooper Life Estate	444/521	10.90
11	4-84	Virgil C. Cooper	320/388	19.98
12	4-85.2	Samuel R. Gieseke & Erin N. Eakin	375/416	4.67
13	4-76	Scott F. & Jeffery M. Grim	387/119	90.00
14	4-86	Janice M. & Michael D. Eddy	188/546	28.63
15	4-87	Janice M. & Michael D. Eddy	188/546	30.24
16	4-88	Janice M. & Michael D. Eddy	188/546	30.10
17	4-90.1	Gary B. & Melinda J. Lewis	473/1	47.33
18	4-90	William J. Grasso	284/609	5.01
19	4-90.2	William J. Grasso	284/609	1.00
20	4-96	James D. Buck	404/633	5.03
21	4-91	Donna Kathy Johnston	184/133	54.06
22	8-12	Grayce Louise Buck	144/482	86.89
23	8-13	Donna Kathy Johnston	184/133	50.00
24	8-24	Theresa J. Drain	428/607	48.38
25	8-23	Elden Jackson & Jennifer Lynn Wryosdick	385/343	30.00
26	8-27	Sharon M. & Jeffery Darrin Deaton	349/176	24.65
27	8-22.2	Michael V. Smith	219/609	1.44
28	8-22	David E. & Ila Grace Kyle	270/206	24.63
29	8-21.1	Justin P. & Stephanie M. Richards	411/189	11.24
30	8-21.4	Jodie E. Michael	373/544	1.78
31	8-21.3	Adam Nathaniel Wayne	236/556	0.78
32	8-21.2	Antero Resources Corp	296/494	52.51
33	8-39	Virginia A. Nalley	218/520	70.65
34	8-19	Olive Branch Animal Rescue & Refuge, Inc	333/804	173.48

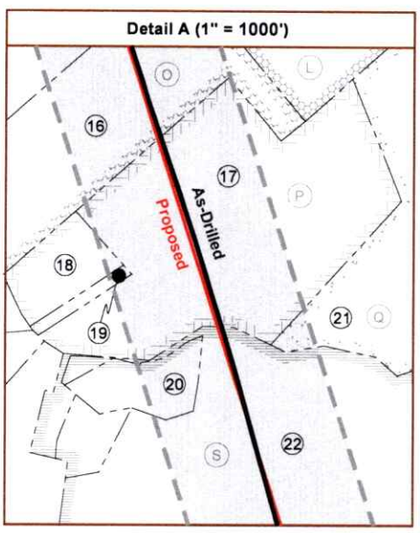

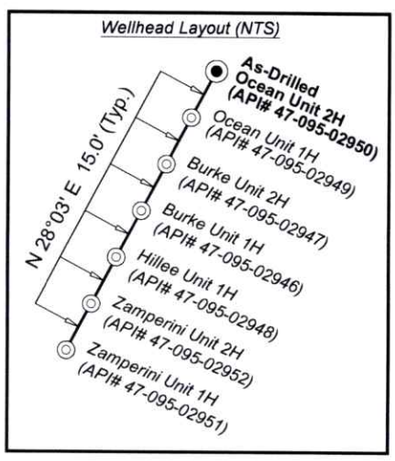

FILE NO: 161-54-L-23
DRAWING NO: Ocean Unit 2H As-Drilled
SCALE: 1" = 2000'
MINIMUM DEGREE OF ACCURACY: Submeter
PROVEN SOURCE OF ELEVATION: WVDOT, Harrisville, WV

STATE OF WEST VIRGINIA
DEPARTMENT OF ENVIRONMENTAL PROTECTION
OIL AND GAS DIVISION

DATE: May 28 20 26
OPERATOR'S WELL NO. Ocean Unit 2H
API WELL NO
47 - 095 - 02950
STATE COUNTY PERMIT

WELL TYPE: ☐ OIL ☒ GAS ☐ LIQUID INJECTION ☐ WASTE DISPOSAL
(IF GAS) PRODUCTION : ☐ STORAGE ☐ DEEP ☒ SHALLOW
LOCATION: ELEVATION: As-Built 1,036' WATERSHED: Outlet Middle Island Creek QUADRANGLE: Paden City
DISTRICT: Lincoln COUNTY: Tyler
SURFACE OWNER: Antero Resources Corp ACREAGE: 52.51 09/25/2026
ROYALTY OWNER: Raymond B. Heintzman & Eva J. Heintzman LEASE NO: _____ ACREAGE: 52.51
PROPOSED WORK: ☐ DRILL ☐ CONVERT ☐ DRILL DEEPER ☐ FRACTURE OR STIMULATE ☐ PLUG OFF OLD FORMATION
☐ PERFORATE NEW FORMATION ☒ OTHER PHYSICAL CHANGE IN WELL (SPECIFY) As-Drilled
☐ PLUG AND ABANDON ☐ CLEAN OUT AND REPLUG TARGET FORMATION: Marcellus Shale ESTIMATED DEPTH: 6,140' TVD 20,372' MD

WELL OPERATOR: Antero Resources Corporation DESIGNATED AGENT: Conrad Baston
ADDRESS: 1615 Wynkoop Street ADDRESS: 535 White Oaks Blvd.
Denver, CO 80202 Bridgeport, WV 26330