

WW-7
8-30-06



West Virginia Department of Environmental Protection
Office of Oil and Gas

WELL LOCATION FORM: GPS

API: 47-033-02412 WELL NO.: Q

FARM NAME: MURRAY, W.C. (IN 2013 A.D. SCHOOL BOARD)

RESPONSIBLE PARTY NAME: ROGER W. MCINTYRE

COUNTY: HARRISON DISTRICT: CLAY

QUADRANGLE: SHINSTON NE1/4

SURFACE OWNER: HARRISON COUNTY SCHOOL BOARD

ROYALTY OWNER: RICE HEIRS AND TOWLES HEIR

UTM GPS NORTHING: ~~N 39* 22.862~~ 4359265.0

UTM GPS EASTING: ~~W 80* 18.591~~ 559444.9 GPS ELEVATION: 960'

GARMIN OREGON 450 - IS CAPABLE OF ALL LISTED HERE AND MORE

The Responsible Party named above has chosen to submit GPS coordinates in lieu of preparing a new well location plat for a plugging permit or assigned API number on the above well. The Office of Oil and Gas will not accept GPS coordinates that do not meet the following requirements:

1. Datum: NAD 1983, Zone: 17 North, Coordinate Units: meters, Altitude: height above mean sea level (MSL) – meters.
2. Accuracy to Datum – 3.05 meters
3. Data Collection Method:

Survey grade GPS X : Post Processed Differential _____

Real-Time Differential _____

Mapping Grade GPS X : Post Processed Differential _____

Real-Time Differential _____


4. Letter size copy of the topography map showing the well location.

I the undersigned, hereby certify this data is correct to the best of my knowledge and belief and shows all the information required by law and the regulations issued and prescribed by the Office of Oil and Gas.

Signature [Signature]

© ROBERT W. MCINTYRE
Title

10/28/2013
Date

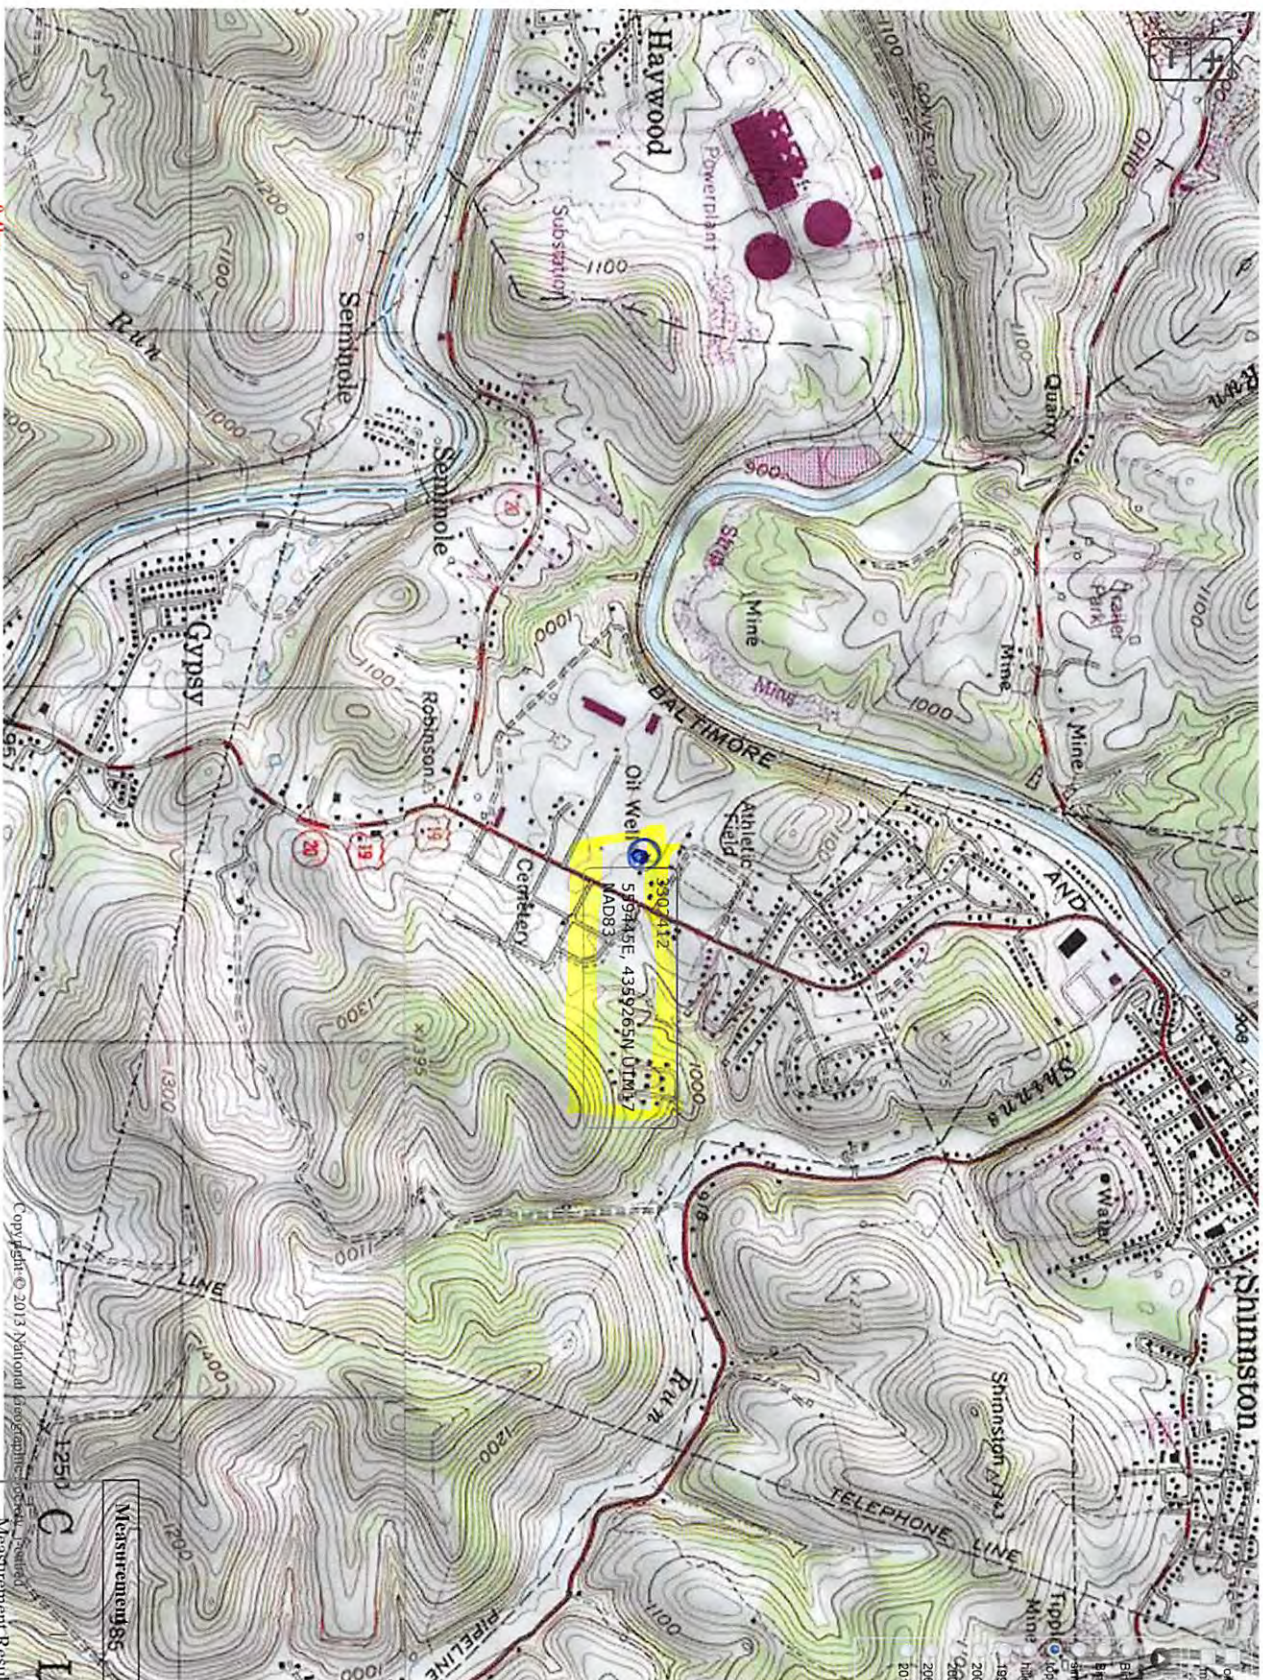

Copyright © 2013 National Geographic, Inc.

Measurement 85
Measurement Result