


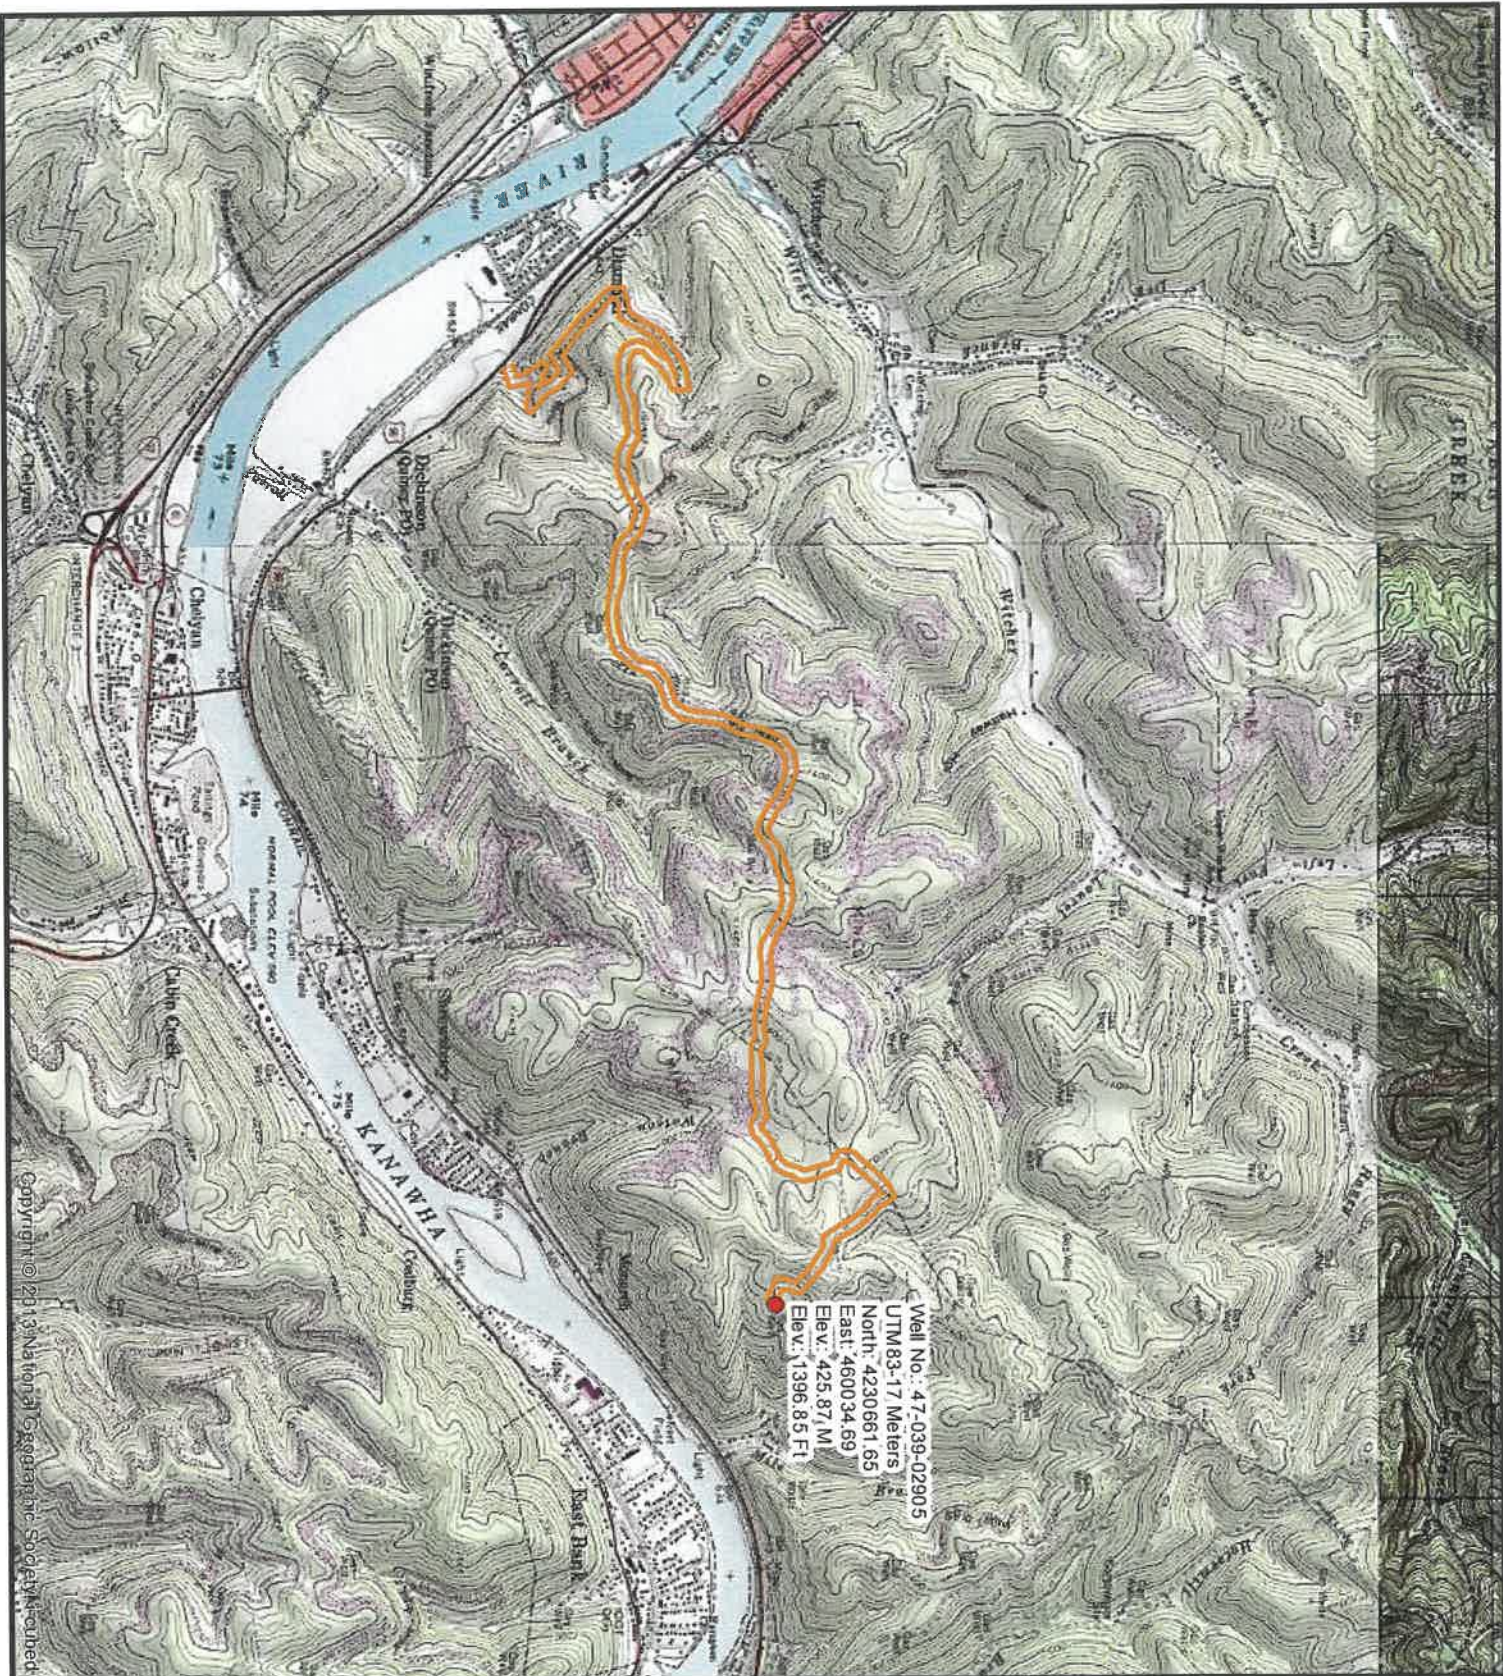

Diversified Gas & Oil
 Corporation
 100 Diversified Way
 Pikeville KY, 41051


07/03/2026

47-039-02905

Plugging Map

Legend

- Well
- Access Road
- Pits
- Pad

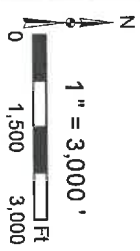



Source: Esri (Aerial), Earthstar Geographics, and the GIS User Community



Diversified Gas & Oil
Corporation
100 Diversified Way
Pikeville KY, 41051



07/03/2026

47-039-02905

Plugging Map

Legend

- Well
- Access Road
- Pits
- Pad
- Public Roads

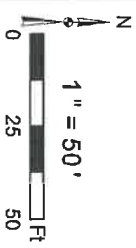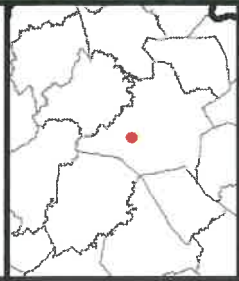

WW-7
8-30-06



West Virginia Department of Environmental Protection
Office of Oil and Gas
WELL LOCATION FORM: GPS

API: 4703902905 WELL NO.: BOWERS WILLIAM 20-643
FARM NAME: Bowers, William
RESPONSIBLE PARTY NAME: Diversified Production, LLC
COUNTY: Kanawha DISTRICT: Cabin Creek
QUADRANGLE: Cedar Grove 7.5'
SURFACE OWNER: Black Hawk Mining, LLC
ROYALTY OWNER: Pardee Oil & Gas, LLC
UTM GPS NORTHING: 4230661.65
UTM GPS EASTING: 460034.69 GPS ELEVATION: 1396.85'

The Responsible Party named above has chosen to submit GPS coordinates in lieu of preparing a new well location plat for a plugging permit or assigned API number on the above well. The Office of Oil and Gas will not accept GPS coordinates that do not meet the following requirements:

1. Datum: NAD 1983, Zone: 17 North, Coordinate Units: meters, Altitude: height above mean sea level (MSL) – meters.
2. Accuracy to Datum – 3.05 meters
3. Data Collection Method:
Survey grade GPS ____: Post Processed Differential ____
Real-Time Differential ____
Mapping Grade GPS X: Post Processed Differential X
Real-Time Differential ____

4. **Letter size copy of the topography map showing the well location.**

I the undersigned, hereby certify this data is correct to the best of my knowledge and belief and shows all the information required by law and the regulations issued and prescribed by the Office of Oil and Gas.

Signature

Nick Bungardner - Permitting Supervisor

Title

Date

07/03/2026