LATITUDE 39° 27' 30"

D

80° 15' 00"

LONGITUDE

7'5 OGIS topo location

7.5' loc 1.595 15' loc _____
' 0.01W (calc.) _____

Company _____

Farm _____

Quad SHINNSTON 7 1/2'

County MARION

District GRANT

Elev 1240 (TOPO)

WELL LOCATION MAP

File No. 049-0356

HOPE NATURAL GAS COMPANY.

LOCATION FOR WELL No. 1658

DISTRICT

Farm, on waters of ..... County, West Virginia


Acres ..... S. ..... E. ..... W.

Scale, one inch equals ..... Sent to 3-23- 1910

Location to be ..... feet from ..... line

..... feet from ..... line

049-366

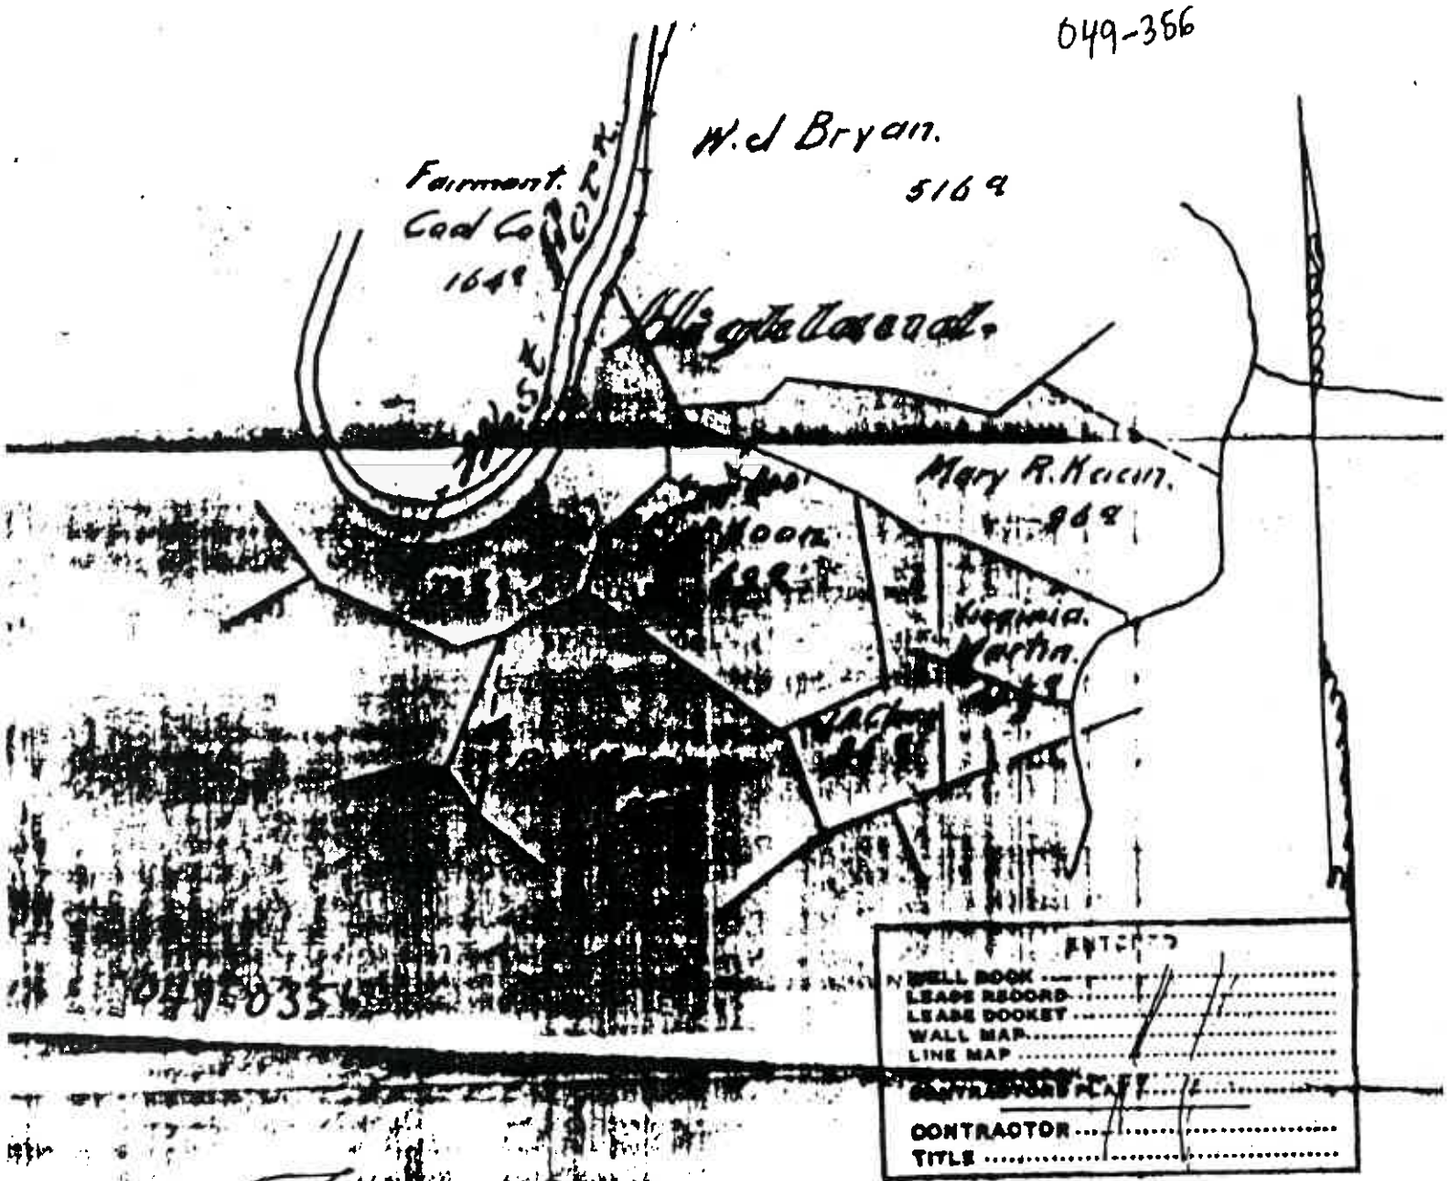

ENTERED	
WELL BOOK	
LEASE RECORD	
LEASE DOCKET	
WALL MAP	
LINE MAP	
CONTRACTOR'S PLAT	
CONTRACTOR	
TITLE	

RESERVE ..... feet ..... line ..... buildings.

SPECIAL INSTRUCTIONS .....

Complete well on or before July 20 1910

Location made ..... As per plat, except as noted. On field m

..... Returned to Pittsburgh .....

Location changed on account of .....

Approved by ..... Date ..... Signed .....

Well No. 1658 — J. N. Kuhn — Farm — 5-19- 1928 — 192

District — Commenced 8-6- 1928

N xxxx S 2 E 80 W — **REPAIRS** — Completed 8- 3- 1928

CASING AND TUBING RECORD

Size	Before Repairs	Pulled	Put in Well	After Repairs	Disposition of Amount Pulled
10	322-0	none	none	322-0	Well Book
6-5/8	1688-0	"	"	1688-0	Lease Book
5-3/16"	2554-0	"	"	2554-0	Wall Map MAY 1928 H.L.L. 30
2"	xxxxxx	"	2751-0	2751-0	Line Map
					Sheets MAY 1928 H.L.L.
					Including 17-4/12 feet 2" Perf,

SHOOTING RECORD

Date	Quarts	Top of Shell	Bottom of Shell	Diameter	Speed	TEST BEFORE SHOT Reading	Liquid	Opening	TEST AFTER SHOT Reading	Liquid	Opening	Test Taken After Shot No. Hours	By Whom Shot
						Not Shot							

RECORD OF ANY DEEPER DRILLING

Formation	Top	Bottom
Commenced drilling at depth of		
Cleaned out on bottom and drilled 38 feet of Pocket.		

Name of Driller	Time (Days)
E. Howard Talkington	

Name of Tool Dresser	Time (Days)
Peter R. Soles	

PACKER RECORD
(ALSO NOTE BELOW IF ANY PACKERS ARE PULLED)

Size	Kind	Anchor	Amount Above Anch
10x15"	O. I. Shoe		322
6-5/8 x 8"	B.H.Packer		1688
5-5/16 x	6-5/8 B.H.Packer		2554
5-3/16 x	2" Seed Bag.	54	2681
5-3/16 x 2"	Dug	192	2543

OIL AND GAS DISCOVERIES IN DEEPER DRILLING

Oil at None Ft. in Sa

Gas at None Ft. in Sa

Total Depth

PRESSURE REPORT

Sands Gas From

th.

E.H.Talkington

				10 Min.	30 Min.	60 Min.	Hrs.
3/4	70	100	108	110	110	115	115	24

Perf. 2555 to 2560-8/12 feet, 1- Right & Left

Packer

W. J. Masters

FOREMAN

049-0356