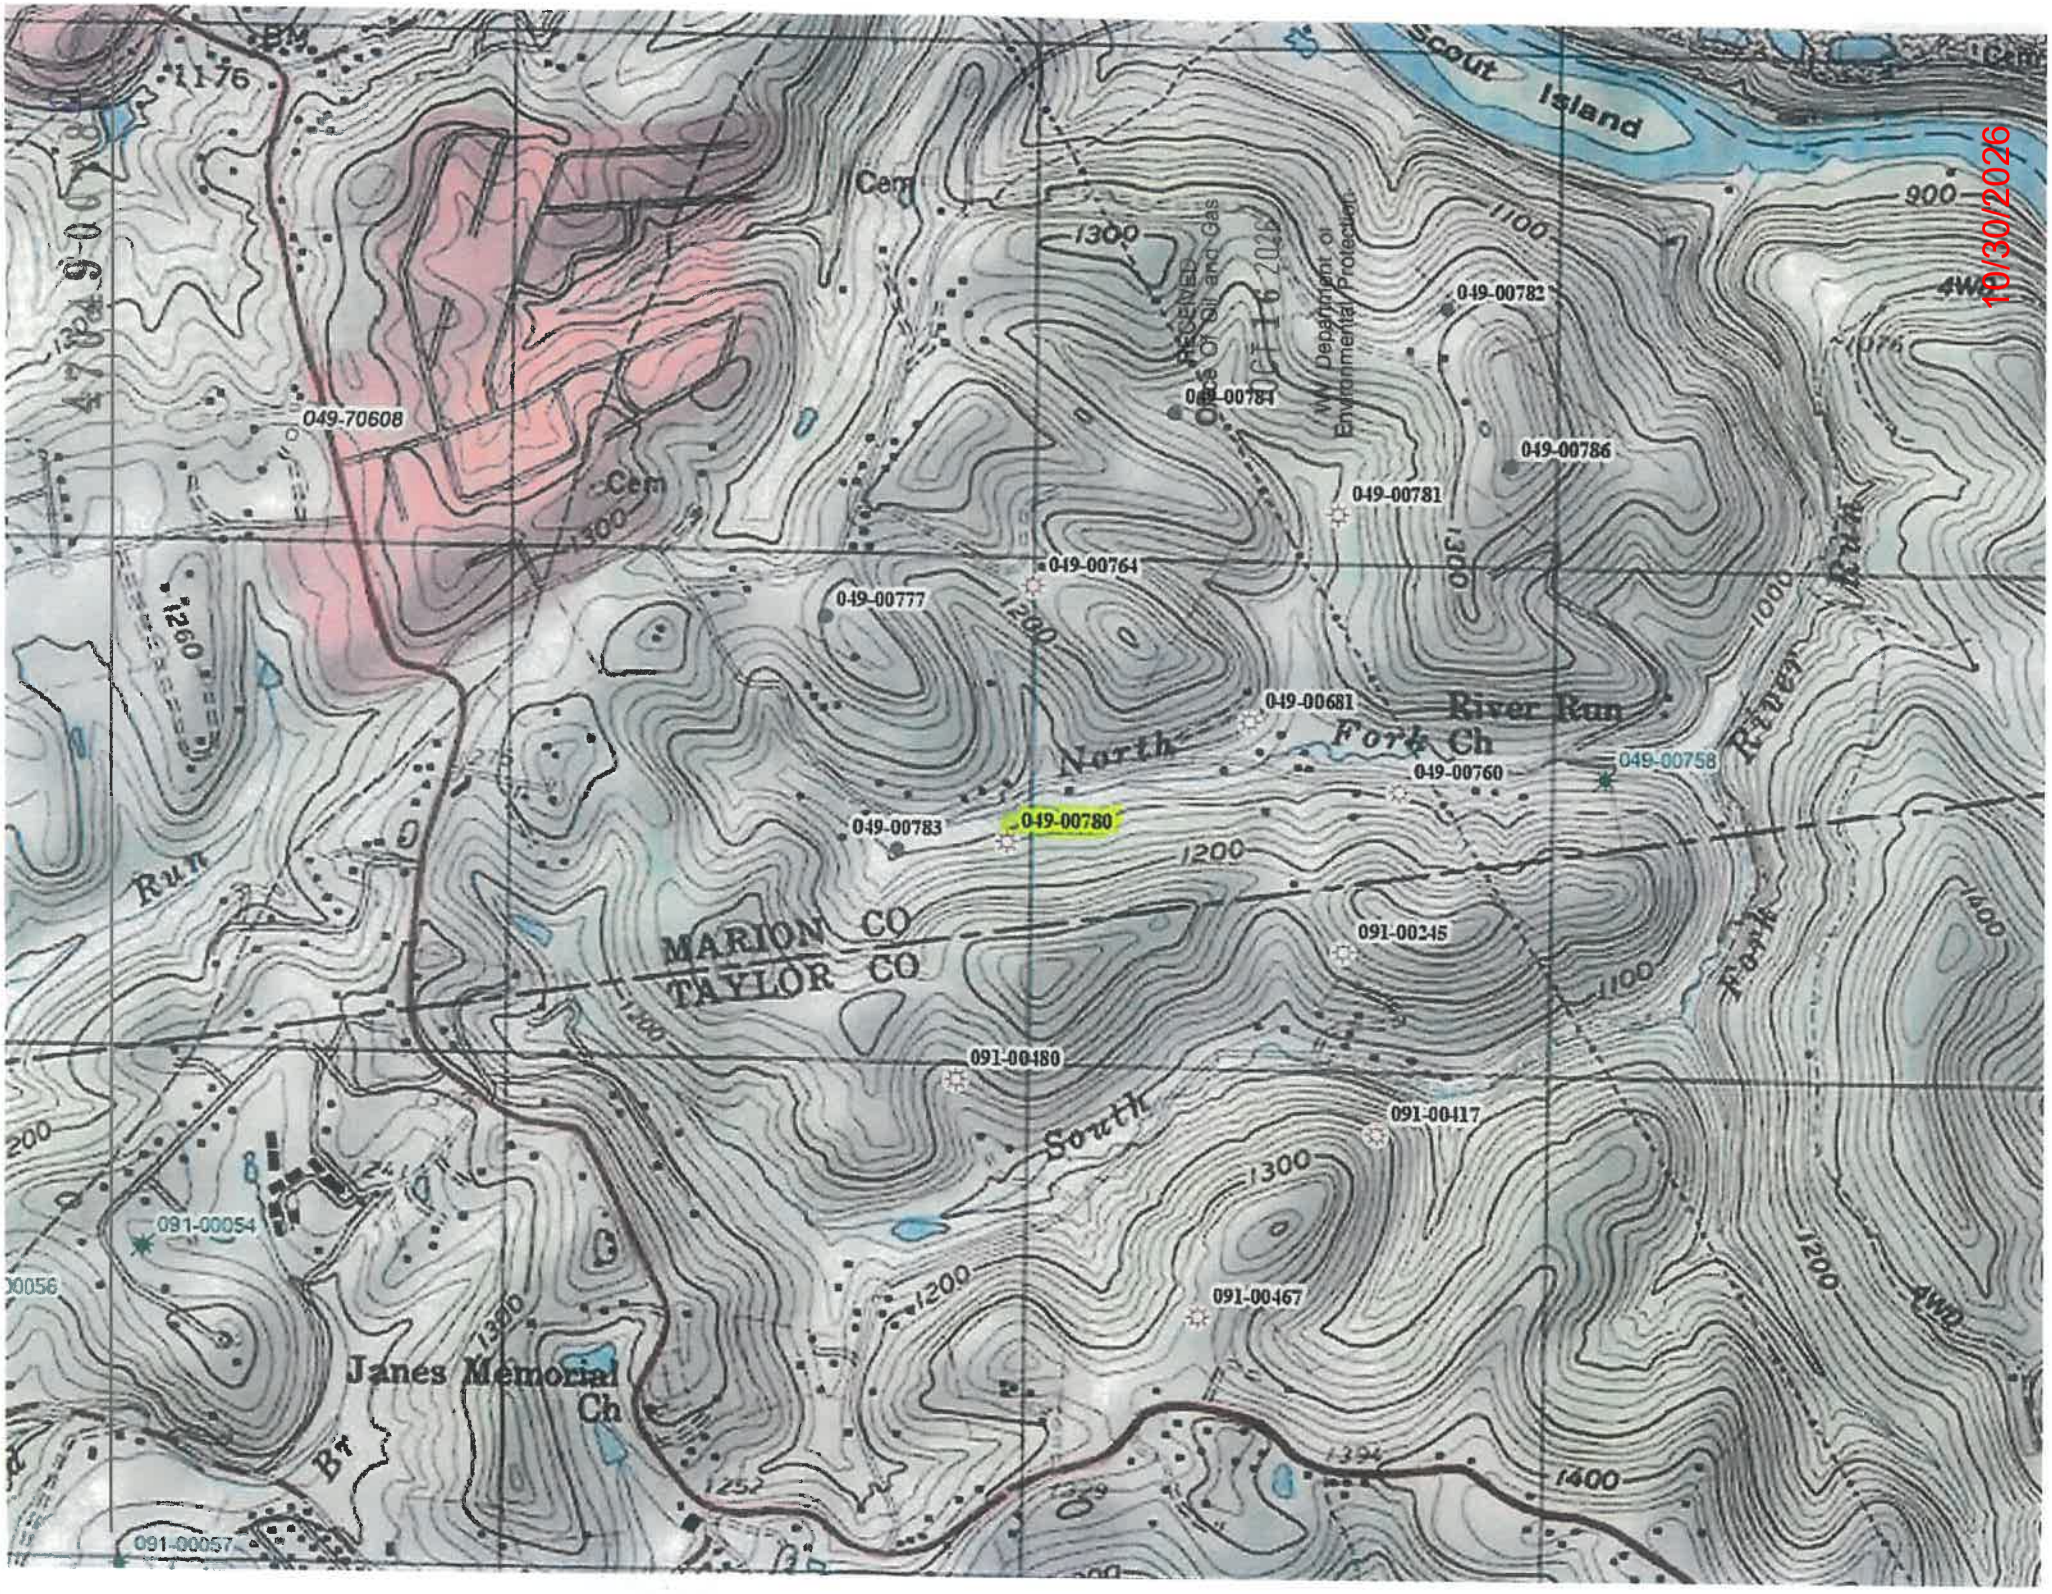
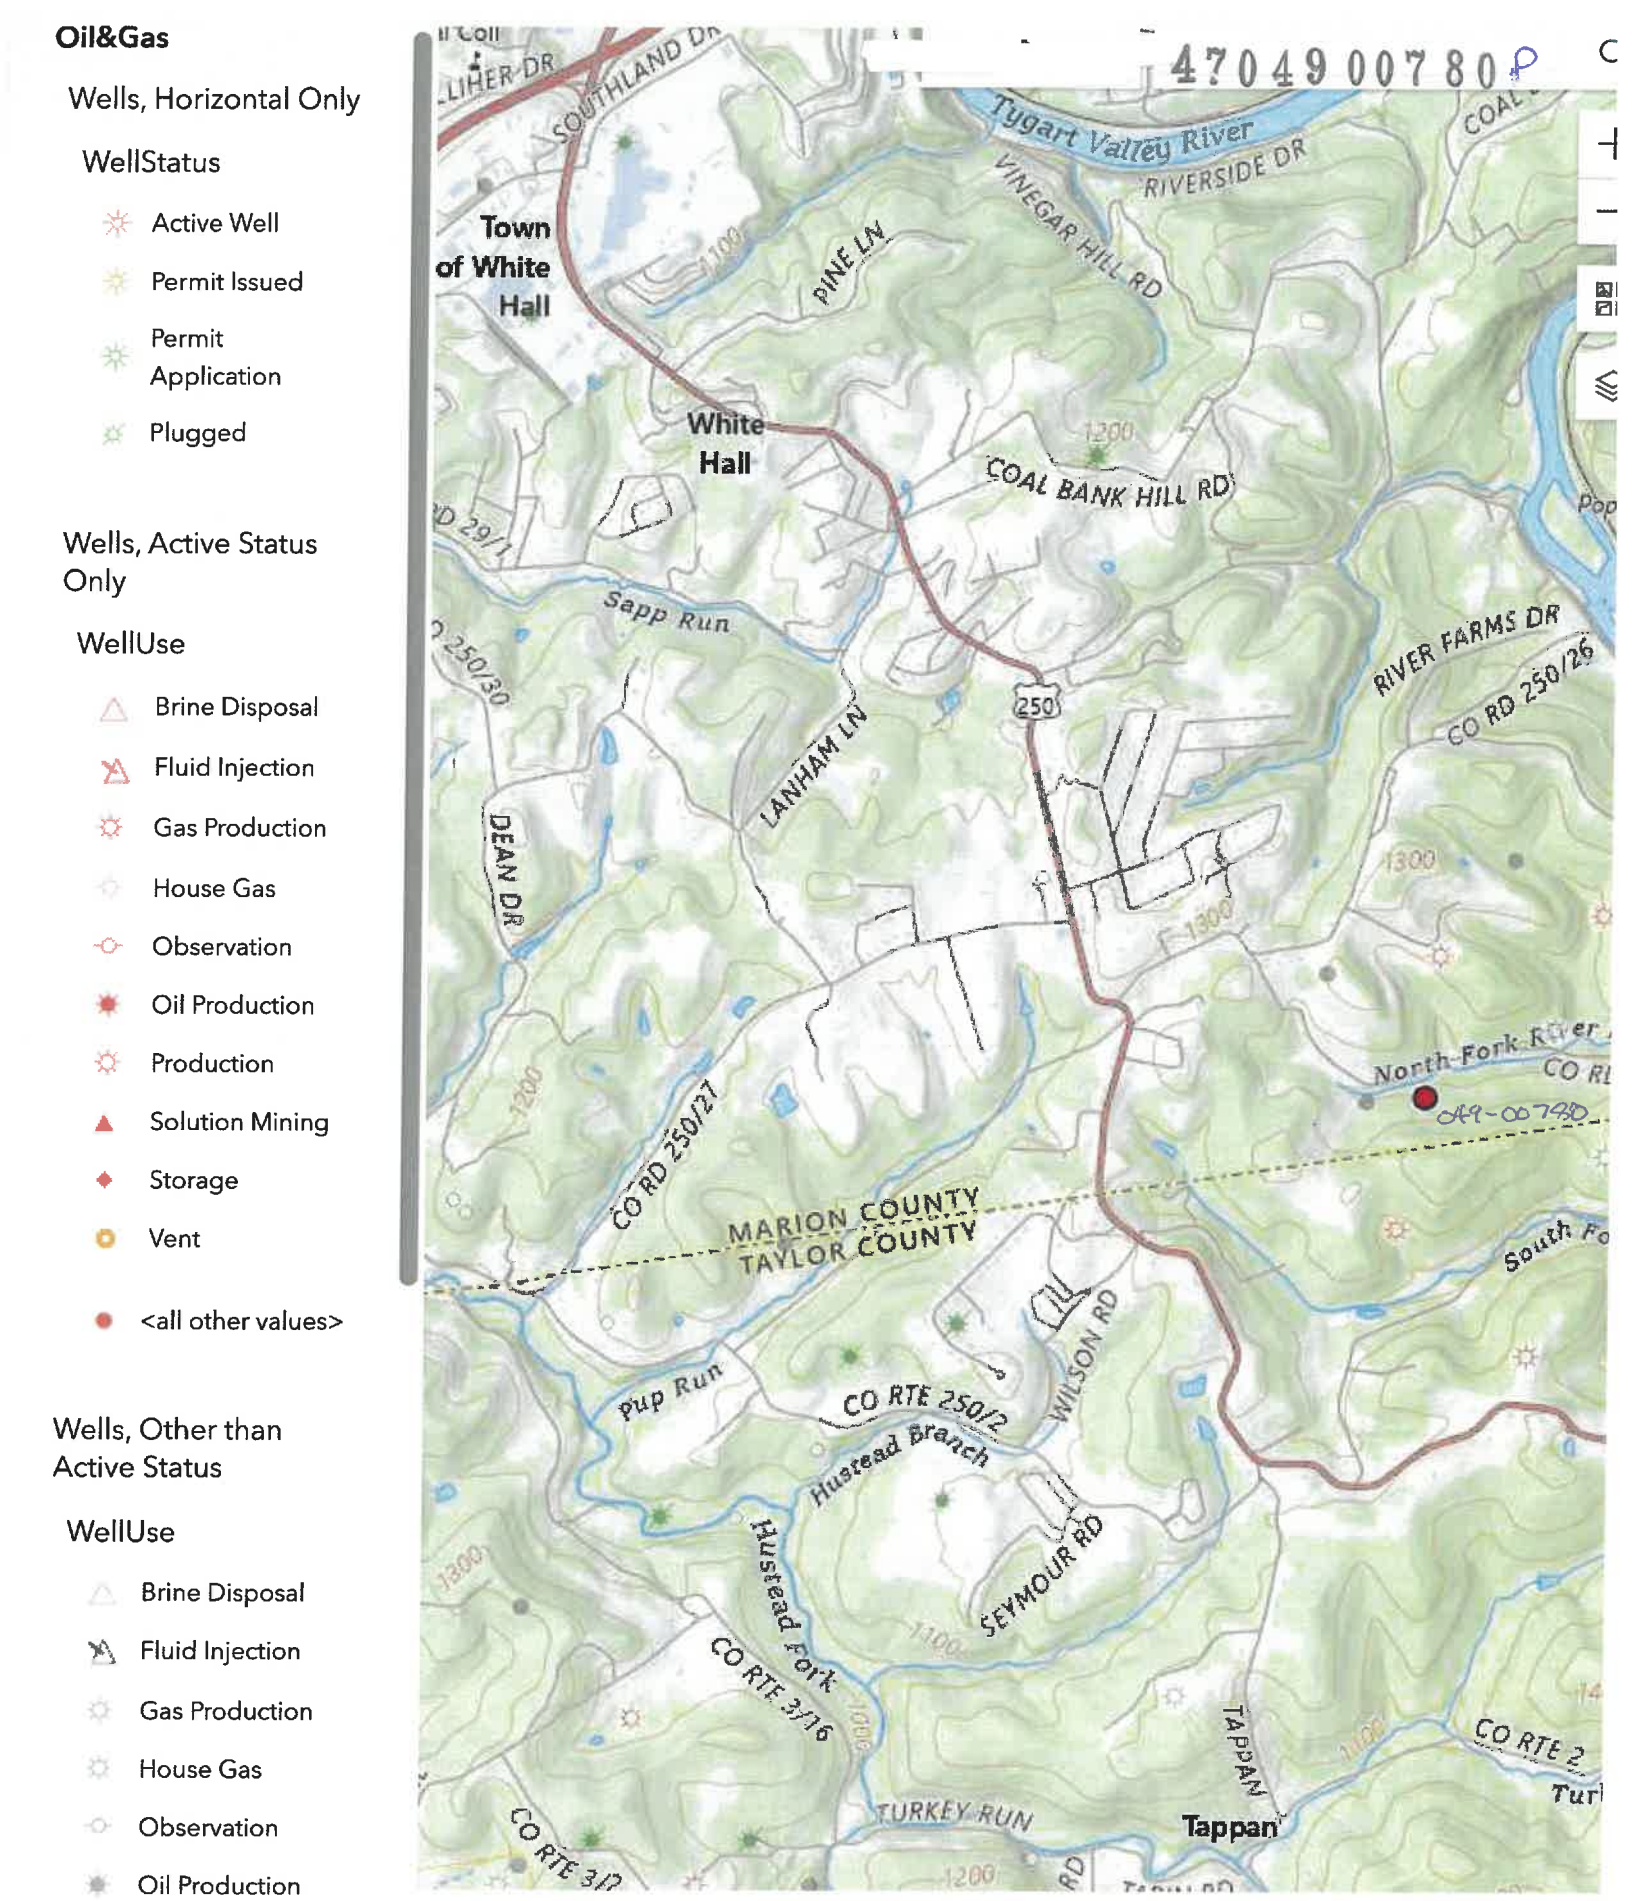

Scout Island
049-00782
049-00784
049-00786
049-00781
049-00764
049-00777
049-00681
River Run
North Fork Ch
049-00760
049-00758
049-00783
049-00780
MARION CO
TAYLOR CO
091-00245
091-00480
091-00417
South
091-00054
091-00467
Janes Memorial Ch
091-00057
049-70608
RECEIVED
Office of Oil and Gas
OCT 16 2025
WV Department of Environmental Protection
10/30/2026


Oil&Gas
Wells, Horizontal Only
WellStatus
Active Well
Permit Issued
Permit Application
Plugged
Wells, Active Status Only
WellUse
Brine Disposal
Fluid Injection
Gas Production
House Gas
Observation
Oil Production
Production
Solution Mining
Storage
Vent
<all other values>
Wells, Other than Active Status
WellUse
Brine Disposal
Fluid Injection
Gas Production
House Gas
Observation
Oil Production
Production
Solution Mining
Storage
4704900780P
Tygart Valley River
RIVERSIDE DR
VINEGAR HILL RD
PINE LN
Town of White Hall
White Hall
COAL BANK HILL RD
Sapp Run
RIVER FARMS DR
CO RD 250/26
LANHAM LN
DEAN DR
250
CO RD 250/27
MARION COUNTY
TAYLOR COUNTY
North Fork River
049-00780
Pup Run
CO RTE 250/2
WILSON RD
Hustead Branch
SEYMOUR RD
Hustead Fork
CO RTE 3/16
TAPPAN
TURKEY RUN
Tappan
begin date
end date
10/30/2026
rainfall tota
update

47049007 80 P

WW-7
8-30-06

West Virginia Department of Environmental Protection
Office of Oil and Gas
WELL LOCATION FORM: GPS

API: 47-049-00780 **WELL NO.:** 565

FARM NAME: Gross

RESPONSIBLE PARTY NAME: R & R Oil and Gas, LLC

COUNTY: Marion **DISTRICT:** Grant

QUADRANGLE: Fairmont West

SURFACE OWNER: Poidomani, Richard V & Heather J.

ROYALTY OWNER: Linda Pauline Raikes, et al

UTM GPS NORTHING: 39.39949 N,4361437.20

UTM GPS EASTING: -80.15216 **GPS ELEVATION:** 1,120 ft
E,572959.70

The Responsible Party named above has chosen to submit GPS coordinates in lieu of preparing a new well location plat for a plugging permit or assigned API number on the above well. The Office of Oil and Gas will not accept GPS coordinates that do not meet the following requirements:

1. Datum: NAD 1983, Zone: 17 North, Coordinate Units: meters, Altitude: height above mean sea level (MSL) – meters.
2. Accuracy to Datum – 3.05 meters
3. Data Collection Method:

Survey grade GPS ____: Post Processed Differential _____

Real-Time Differential _____

Mapping Grade GPS X: Post Processed Differential _____

Real-Time Differential _____

4. **Letter size copy of the topography map showing the well location.**

I the undersigned, hereby certify this data is correct to the best of my knowledge and belief and shows all the information required by law and the regulations issued and prescribed by the Office of Oil and Gas.

Libby Taylor — Signature
Managing Member — Title
10/14/2026 — Date

RECEIVED
Office Of Oil and Gas
OCT 16 2026
WV Department of
Environmental Protection

10/30/2026