


LATITUDE 39° 42' 30" TH: 7,050'

LONGITUDE 80° 20' 00" TH: 6,445'

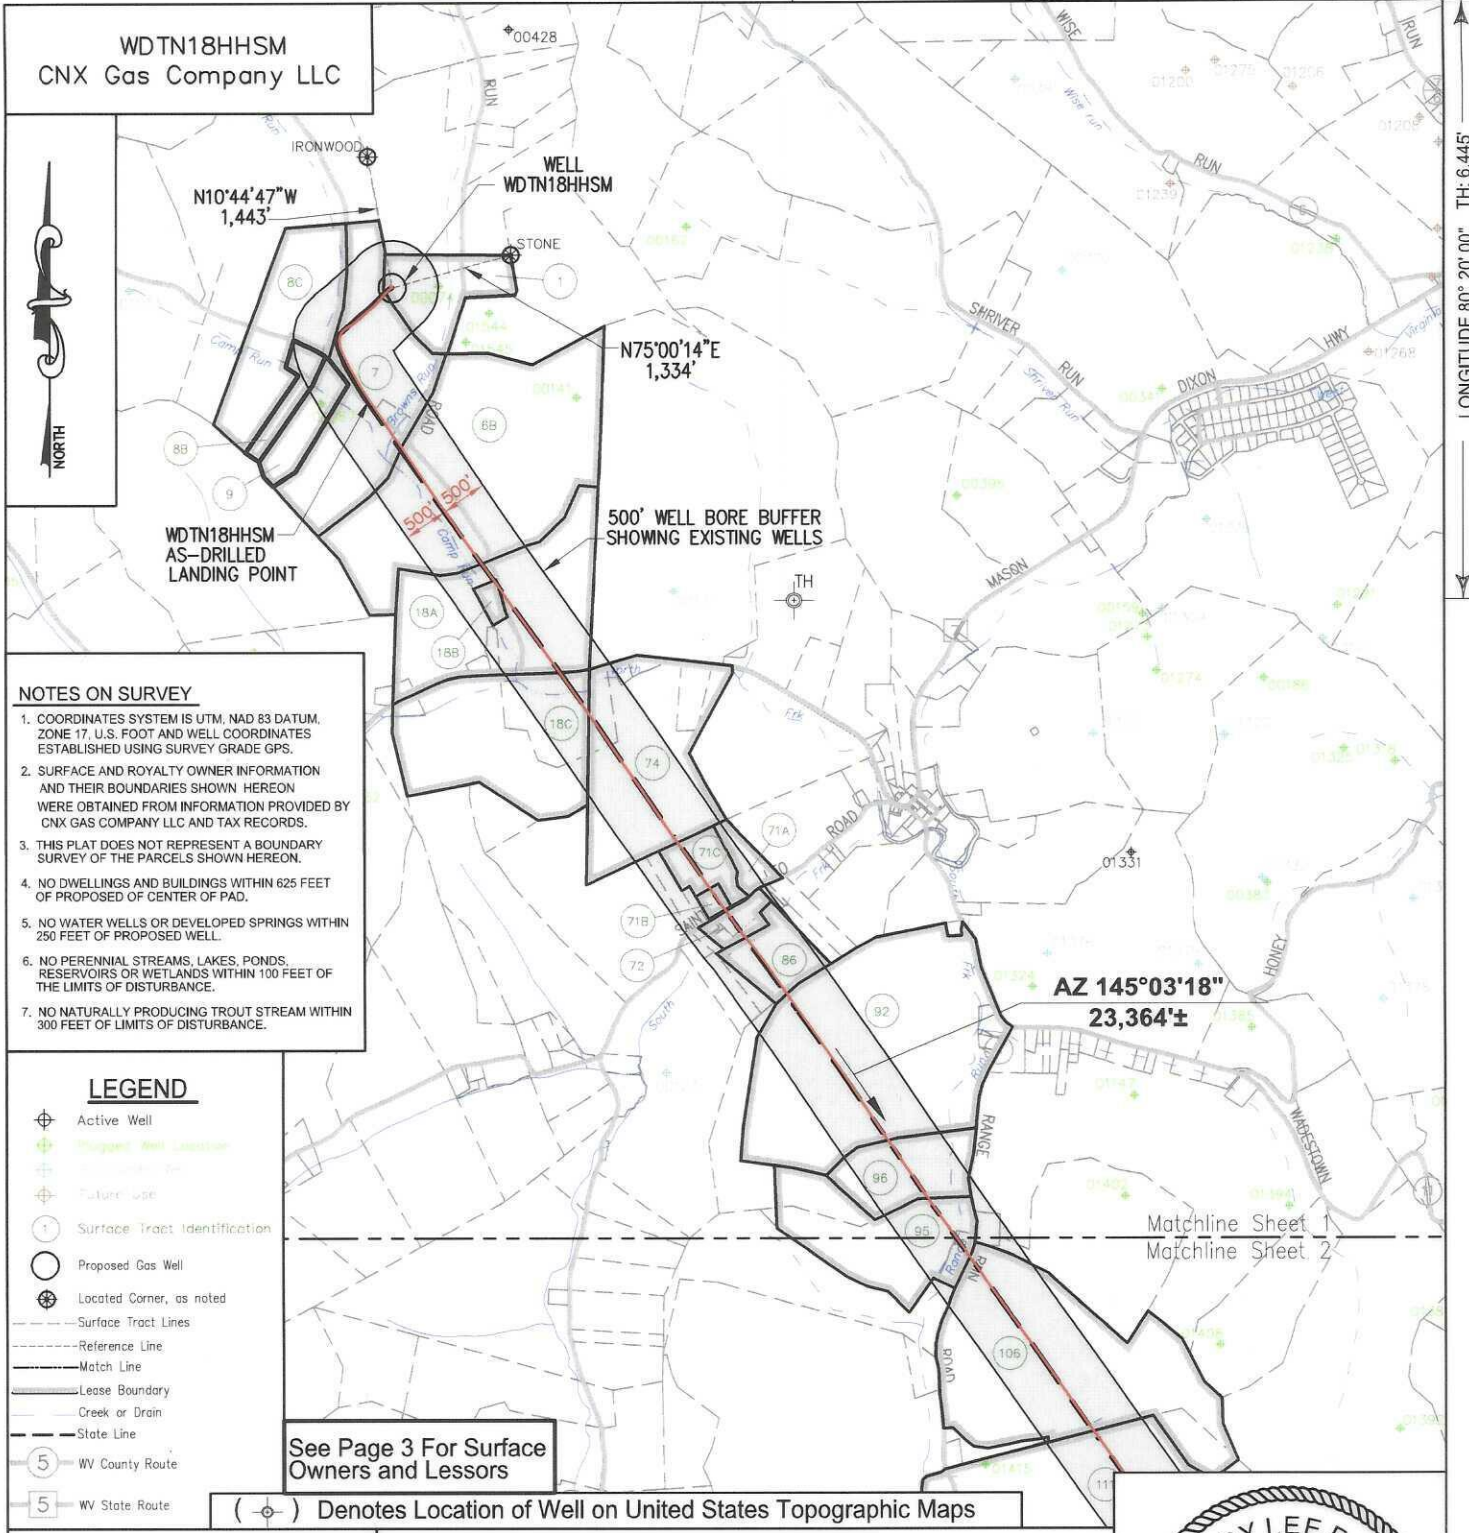

- NOTES ON SURVEY**
1. COORDINATES SYSTEM IS UTM, NAD 83 DATUM, ZONE 17, U.S. FOOT AND WELL COORDINATES ESTABLISHED USING SURVEY GRADE GPS.
 2. SURFACE AND ROYALTY OWNER INFORMATION AND THEIR BOUNDARIES SHOWN HEREON WERE OBTAINED FROM INFORMATION PROVIDED BY CNX GAS COMPANY LLC AND TAX RECORDS.
 3. THIS PLAT DOES NOT REPRESENT A BOUNDARY SURVEY OF THE PARCELS SHOWN HEREON.
 4. NO DWELLINGS AND BUILDINGS WITHIN 625 FEET OF PROPOSED OF CENTER OF PAD.
 5. NO WATER WELLS OR DEVELOPED SPRINGS WITHIN 250 FEET OF PROPOSED WELL.
 6. NO PERENNIAL STREAMS, LAKES, PONDS, RESERVOIRS OR WETLANDS WITHIN 100 FEET OF THE LIMITS OF DISTURBANCE.
 7. NO NATURALLY PRODUCING TROUT STREAM WITHIN 300 FEET OF LIMITS OF DISTURBANCE.

- LEGEND**
- Active Well
 - Proposed Well Location
 - Future Well
 - Surface Tract Identification
 - Proposed Gas Well
 - Located Corner, as noted
 - Surface Tract Lines
 - Reference Line
 - Match Line
 - Lease Boundary
 - Creek or Drain
 - State Line
 - WV County Route
 - WV State Route

See Page 3 For Surface Owners and Lessors

() Denotes Location of Well on United States Topographic Maps




I, the undersigned, hereby certify that this plat is correct to the best of my knowledge and belief and shows all the information required by law and the regulations issued and prescribed by the Department of Environmental Protection.

Terry Lee Rowe
L. L. S. 2394




FILE NO:
DRAWING NO:
SCALE: 1" = 2000'
MINIMUM DEGREE OF ACCURACY: 1:2500
PROVEN SOURCE OF ELEVATION: NGS CORS Station

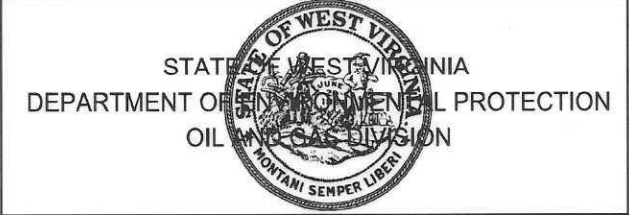

DATE: MARCH 20 20 26
OPERATORS WELL NO:
API WELL NO
47 - 061 - 02001
STATE COUNTY PERMIT


WELL TYPE: ☐ OIL ☒ GAS ☐ LIQUID INJECTION ☐ WASTE DISPOSAL
(IF GAS) PRODUCTION: ☐ STORAGE ☐ DEEP ☒ SHALLOW
LOCATION ELEVATION: 1199' WATERSHED: Dunkard Creek QUADRANGLE: Wadestown
DISTRICT: Battelle COUNTY: Monongalia
SURFACE OWNER: Consol Mining Company LLC ACREAGE: 46.75 ±
ROYALTY OWNER: Bounty Minerals, LLC LEASE NO: 189033000 ACREAGE: 59.02 ±
PROPOSED WORK: ☒ DRILL ☐ CONVERT ☐ DRILL DEEPER ☒ FRACTURE OR STIMULATE ☐ PLUG OFF OLD FORMATION
☐ PERFORATE NEW FORMATION ☐ OTHER PHYSICAL CHANGE IN WELL (SPECIFY)
☐ PLUG AND ABANDON ☐ CLEAN OUT AND REPLUG TARGET FORMATION: Marcellus ESTIMATED DEPTH: TVD: 7,847'
WELL OPERATOR: CNX Gas Company LLC DESIGNATED AGENT: Anthony Kendziora
ADDRESS: 1000 Horizon Vue Drive ADDRESS: 111 Avondale Road
Canonsburg, PA 15317 Fairmont, WV 26554

AS-DRILLED

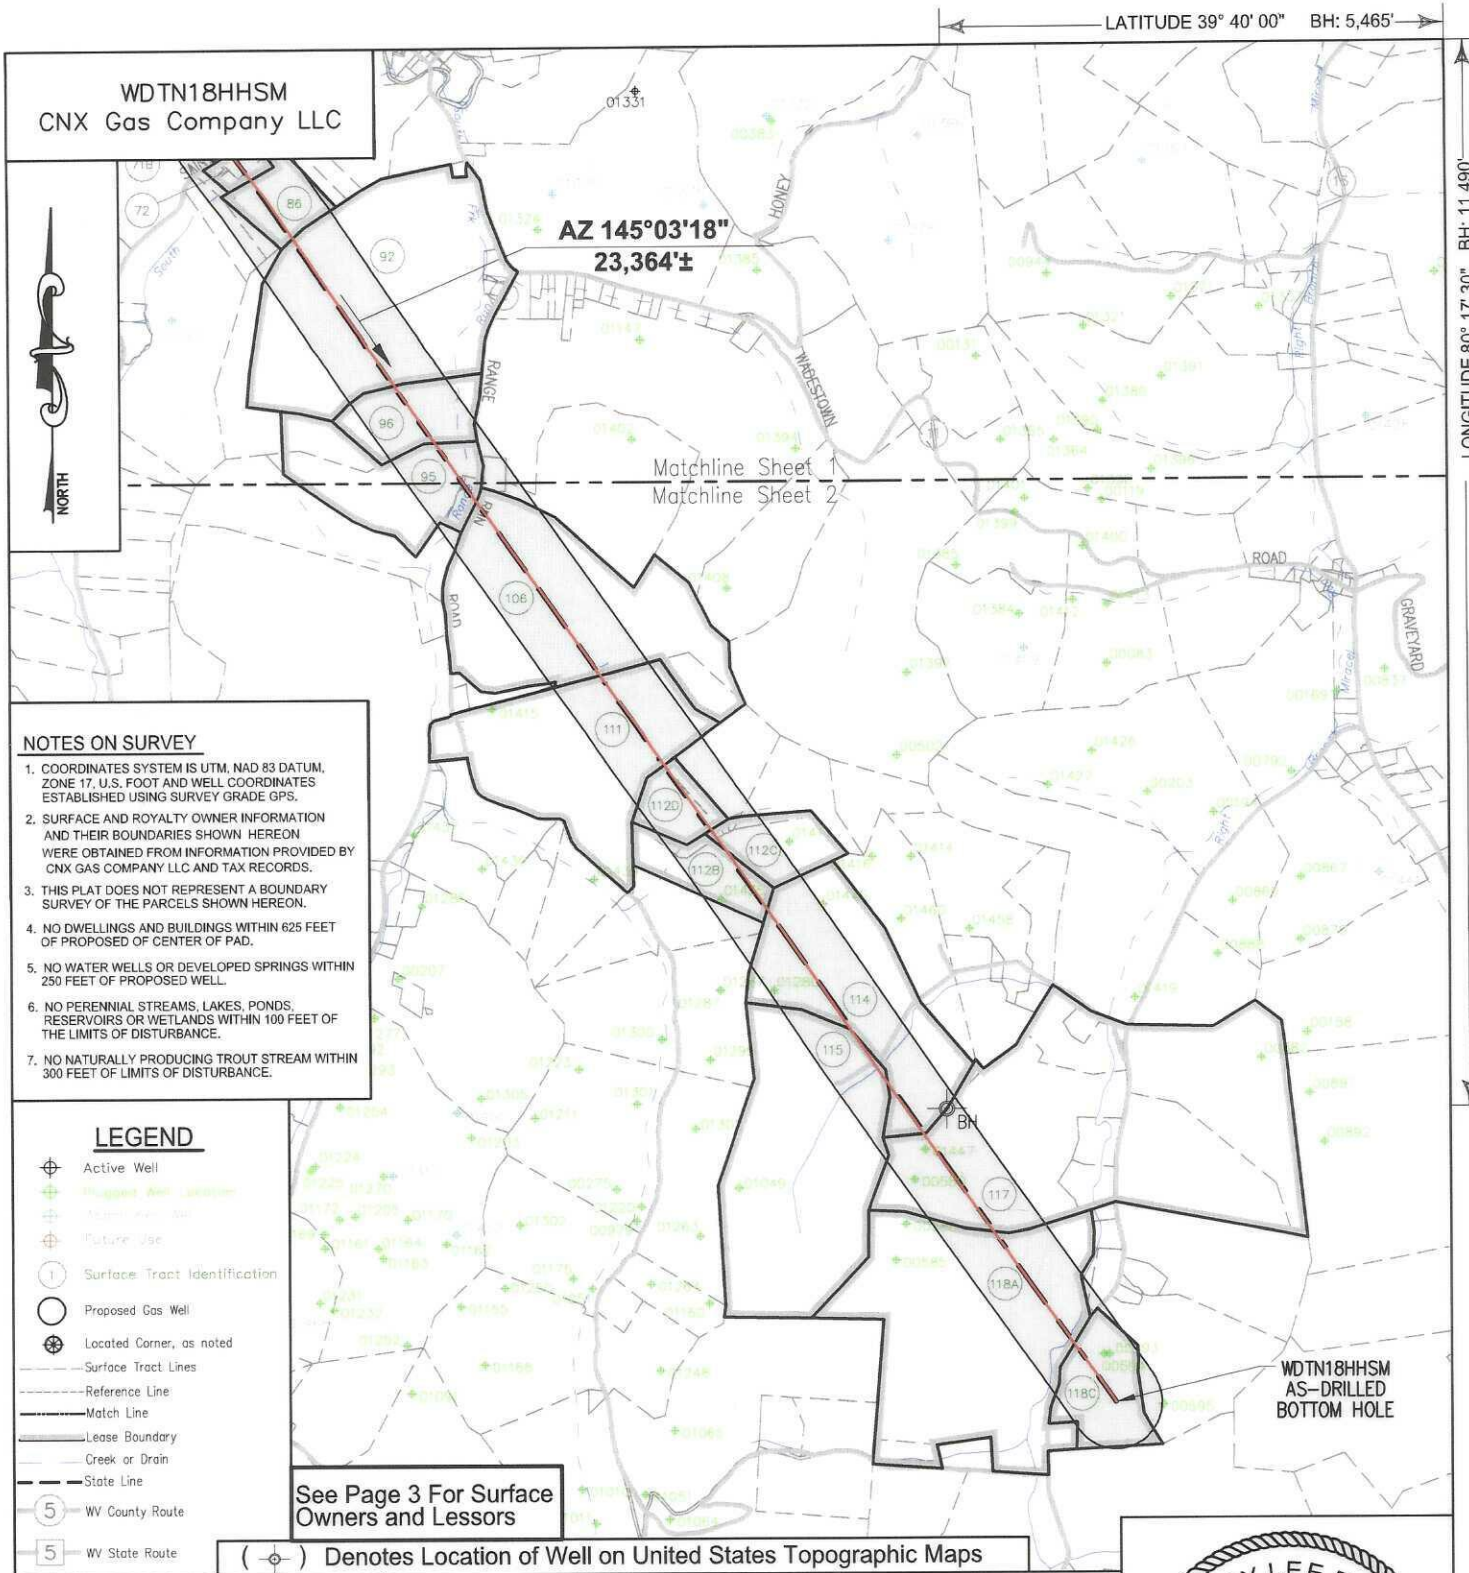



I, the undersigned, hereby certify that this plat is correct to the best of my knowledge and belief and shows all the information required by law and the regulations issued and prescribed by the Department of Environmental Protection.

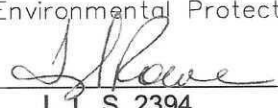
L.L. S. 2394



FILE NO:		DATE: MARCH 20 20 26
DRAWING NO:		OPERATORS WELL NO:
SCALE: 1" = 2000'		API WELL NO 47 - 061 - 02001
MINIMUM DEGREE OF ACCURACY: 1:2500		STATE COUNTY PERMIT
PROVEN SOURCE OF ELEVATION: NGS CORS Station		

WELL TYPE: ☐ OIL ☒ GAS ☐ LIQUID INJECTION ☐ WASTE DISPOSAL
(IF GAS) PRODUCTION: ☐ STORAGE ☐ DEEP ☒ SHALLOW

LOCATION ELEVATION: 1199' WATERSHED: Dunkard Creek QUADRANGLE: Wadestown
DISTRICT: Battelle COUNTY: Monongalia



SURFACE OWNER: Consol Mining Company LLC ACREAGE: 46.75 ±
ROYALTY OWNER: Bounty Minerals, LLC LEASE NO: 189033000 ACREAGE: 59.02 ±

PROPOSED WORK: ☒ DRILL ☐ CONVERT ☐ DRILL DEEPER ☒ FRACTURE OR STIMULATE ☐ PLUG OFF OLD FORMATION
☐ PERFORATE NEW FORMATION ☐ OTHER PHYSICAL CHANGE IN WELL (SPECIFY)
☐ PLUG AND ABANDON ☐ CLEAN OUT AND REPLUG TARGET FORMATION: Marcellus ESTIMATED DEPTH: TVD: 7,847'

WELL OPERATOR: CNX Gas Company LLC	DESIGNATED AGENT: Anthony Kendziora
ADDRESS: 1000 Horizon Vue Drive	ADDRESS: 111 Avondale Road
Canonsburg, PA 15317	Fairmont, WV 26554

AS-DRILLED

TRACT ID	SURFACE OWNER	LESSOR	PIN
1	Consol Mining Company LLC	Eastern Associated Coal Corporation	1-9-38 1-9-37
TRACT ID	SURFACE OWNER	LESSOR	PIN
6B	CONSOL Mining Company LLC	Virgie Shriver, et al	1-12-8
		Eastern Associated Coal Corp.	
		CNX Gas Company LLC	
		Consolidation Coal Company	
TRACT ID	SURFACE OWNER	LESSOR	PIN
7	Consol Mining Company LLC	Bounty Minerals, LLC	1-9-37 1-12-7
		Bounty Minerals III Acquisitions, LLC	
		LOIA Drilling I, LLC	
		Rice Drilling B, LLC	
TRACT ID	SURFACE OWNER	LESSOR	PIN
8B	Consol Mining Company LLC	Martha Sue Kerr	1-12-5
		Larry A. Kerr	
		Antero Resources Corporation	
		Bruce Scott Carpenter	
		Patti Carpenter	
		Bruce P. Carpenter	
		Jeannine Osmanski and Robert E. Osmanski, w/h	

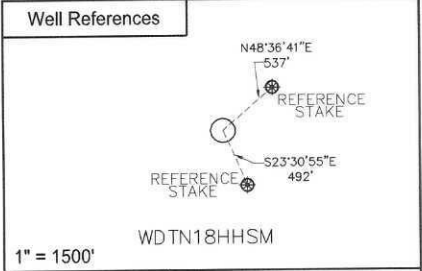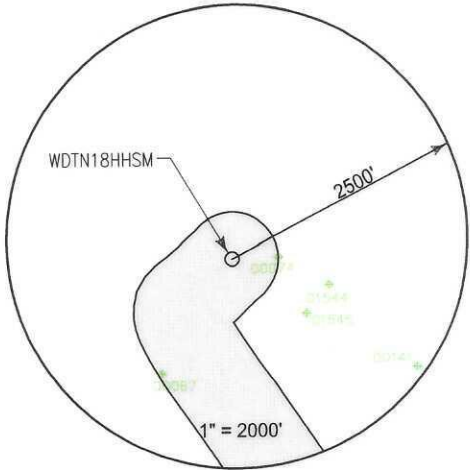

SURFACE HOLE LOCATION (SHL)
UTM 17 NAD 83
N: 4393619.004
E: 555014.540
NAD 83, WV NORTH
N: 434820.701
E: 1726948.087
LAT/LON DATUM NAD 83
LAT: 39°41'26.306"
LON: 80°21'30.190"
LANDING POINT
UTM 17 NAD 83
N: 4393253.36
E: 554943.86
NAD 83, WV NORTH
N: 433624.755
E: 1726696.094
LAT/LON DATUM NAD 83
LAT: 39°41'14.463"
LON: 80°21'33.267"

WDTN18 WELL PAD	BOTTOM HOLE LOCATION (BHL)
WDTN18HHSM ○ ○ WDTN18JHSM	UTM 17 NAD 83
WDTN18GHSM ○ ○ WDTN18KHSM	N: 4387486.83
WDTN18FHSM ○ ○ WDTN18VHSM	E: 559118.15
	NAD 83, WV NORTH
	N: 414473.894
	E: 1740077.385
	LAT/LON DATUM NAD 83
	LAT: 39°38'06.423"
	LON: 80°18'39.885"



I, the undersigned, hereby certify that this plat is correct to the best of my knowledge and belief and shows all the information required by law and the regulations issued and prescribed by the Department of Environmental Protection.

L. L. S. 2394
L. L. S. 2394



FILE NO: _____
DRAWING NO: _____
SCALE: 1" = 1000'
MINIMUM DEGREE OF ACCURACY: 1:2500
PROVEN SOURCE OF ELEVATION: NGS CORS Station

STATE OF WEST VIRGINIA
DEPARTMENT OF ENVIRONMENTAL PROTECTION
OIL AND GAS



DATE: MARCH 20 20 26
OPERATORS WELL NO: _____
API WELL NO: 47 - 061 - 02001
STATE COUNTY PERMIT

WELL TYPE: ☐ OIL ☒ GAS ☐ LIQUID INJECTION ☐ WASTE DISPOSAL
(IF GAS) PRODUCTION: ☐ STORAGE ☐ DEEP ☒ SHALLOW
LOCATION ELEVATION: 1199' WATERSHED: Dunkard Creek QUADRANGLE: Wadestown
DISTRICT: Battelle COUNTY: Monongalia
SURFACE OWNER: Consol Mining Company LLC ACREAGE: 46.75 ±
ROYALTY OWNER: Bounty Minerals, LLC LEASE NO: 189033000 ACREAGE: 59.02 ±
PROPOSED WORK: ☒ DRILL ☐ CONVERT ☐ DRILL DEEPER ☒ FRACTURE OR STIMULATE ☐ PLUG OFF OLD FORMATION
☐ PERFORATE NEW FORMATION ☐ OTHER PHYSICAL CHANGE IN WELL (SPECIFY) _____
☐ PLUG AND ABANDON ☐ CLEAN OUT AND REPLUG TARGET FORMATION: Marcellus ESTIMATED DEPTH: TVD: 7,847'
WELL OPERATOR: CNX Gas Company LLC DESIGNATED AGENT: Anthony Kendziora
ADDRESS: 1000 Horizon Vue Drive ADDRESS: 111 Avondale Road
Canonsburg, PA 15317 Fairmont, WV 26554

TRACTID	SURFACE OWNER	LESSOR	PIN
8C	Consol Mining Company LLC	Martha Sue Kerr	1-9-36
		Larry A. Kerr	
		Antero Resources Corporation	
		Bruce Scott Carpenter	
		Patti Carpenter	
		Bruce P. Carpenter	
		Jeannine Osmanski and Robert E. Osmanski, w/h	
		Rodney A Clovis	
		Christopher Lance Clovis	
		Timothy Steele Clovis a/k/a Timothy S. Clovis	
		Clinton Alan Clovis a/k/a Clint Clovis	
		Robin L. Clovis Wade a/k/a Robin Lynn Clovis	
		James Douglas Campbell	
		Robert York Uren	
		Pennie Mae Gurley	
		Tiffany May Coker and Micahel D. Coker, w/h	
		Joseph Allen Campbell and Kathryn Ernst Campbell, h/w	
		Dorothy Ione Harcum	
		David Hilirion Campbell and Sheryl L. Campbell, h/w	
		Regina Kay Orfanos and Anthony Orfanos, w/h	
		Michelle Law	
		Tina Law	
		Robin Lynn Campbell	
		Susan Cale Teter and Gary Teter, w/h	
		John Edward Cale	
		Karen L. Haught and Jimmie A. Haught, w/h	
		Edwin R. White a/k/a Eddie White and Patricia White, h/w	
		Cherrie Anderson Yost a/k/a Cherrie Anderson Yost	
		Douglas Yost	
		David Yost	
		Nancy Bohannon	
		Mary Jo Morris	
		Janet Eglund	
		David Allen Jolliffe and Donna Sue A. Jolliffe, h/w	
		Lisa Ellen May and Gary A. May, w/h	
		William James Shannon	
		Nancy Paulovicks	
		Robert Owens and Earlene Owens, h/w	
		Mary Ellen Bell	
		Martha Ann Prince	
		Charles R. Delaney	
		Shawn Delaney	
		Larry Delaney	
		George William Cummins, Jr.	
		Lee E. Delaney and Shannon Delaney, h/w	
		Susan D. Delaney	
		Joseph S. Delaney	
		Michael S. Delaney and Susan Delaney, h/w	
		Nola Chisler and Charles D. Chisler, w/h	
		Jay Park and Carolyn S. Park, h/w	
		Donna J. Glaspell a/k/a Donna J. Snyder	
		Debra Lynn Lundgren	
		Cheryl Darlene Fordyce	
		Robert Henderson Fordyce a/k/a Robert H. Fordyce and Patricia A. Fordyce, h/w	
		Martha Sue Cvechko and John M. Cvechko, w/h	
		Brenda Lou Painter f/k/a Brenda Lou Henderson	
		Cheryl Lynn Stout	
		James Michael Cale and Laura W. Cale, h/w	
		John Smith	
		Robert L. Smith a/k/a Bob Smith and Carol Smith, h/w	
		William M. Smith a/k/a Bill Smith and Ruth C. Smith, h/w	
		Greg Rowland and Brady Rowland, h/w	
		Carol Neal	
		William F. Henderson a/k/a Willaim F. Hendeson a/k/a Bill Henderson	
		Steve Edward Henderson	
		Matthew David Stiles	
		Mark Douglas Stiles, a/k/a Mark Dougas Stiles	
		Marcia Stiles Batson	
		James Aspinall and Marion Aspinall, h/w	
		Robert S. Elliott	
		Robert Scott Davis and Jennifer Davis, h/w	
		Christopher Chad Davis	
		Richard Todd Davis and Kimberly Renee Davis, h/w	
		Olen Ray Harker	
		Jo Ann Henderson	
		John Gaertner	
		Taylor Nicole Best	
		Kevin Russell Beasley	
		Magnus Audbjorn Sonoffthor	
		Shannon Renee Sutton	
		Jessica Bergevine	
		Drema L. Howard	
		Arnold Lebron Uren	
		Victor A. White	
		CNX Resource Holding LLC	

08/28/2026

TRACT ID	SURFACE OWNER	LESSOR	PIN
9	CNX RCPC LLC	Marion C. Martell	1-12-6
		Terra Firma Company	
		CNX Land LLC	
TRACT ID	SURFACE OWNER	LESSOR	PIN
18A	David E. Van Scyoc	Three Rivers Royalty II, LLC	1-12-10 1-12-10.1 1-12-11 1-12-11.1 1-12-11.2 1-12-11.3
		WhiteHawk Income Marcellus LLC	
		David A. Joliffe and Donna Sue A. Joliffe	
		Lisa Ellen May and Gary A. May	
		Jeff T. Delaney	
		Martha A. Pryor a/k/a Martha Ann Pryor by Robert Owens as Agent	
		Lee E. Delaney	
		Joseph S. Delaney	
		Nancy Paulovicks and Jay E. Paulovicks, wife and husband	
		Michael S. Delaney	
		Earlene Owens and Robert Owens, wife and husband	
		W. James Shannon	
		Clarence Park and Linda S. Park, husband and wife	
		Linda L. Park	
		Nola Chisler and Charles D. Chisler, wife and husband	
		Jay Park and Carolyn S. Park, husband and wife	
		Martha Ann Prince	
		Mary Ellen Bell	
		Larry L. Delaney	
		Shawn Delaney	
		Charles R. Delaney	
		George William Cummins Jr	
		Hillary L. Clovis and Kristen Clovis, her wife	
		Jeremy J. Clovis and Wendy Clovis, his wife	
		Josh Clovis a/k/a Joshua Clovis and Chastity Clovis, his wife	
		Chelsa D. Kolb n/k/a Chelsa Hagedorn and Kevin Hagedorn, her husband	
		Rodney A. Clovis	
		Robin L. Clovis Wade, f/k/a Robin Lynn Clovis	
		Clinton Alan Clovis a/k/a Clint Clovis	
		Christopher Lance Clovis	
		Bruce Scott Carpenter and Patricia S. Carpenter, individually and as husband and wife	
		Patti Carpenter	
		Bruce P. Carpenter	
		Jeannine Osmanski and Robert E. Osmanski, individually and as husband and wife	
		NNE Properties II LLC	
		Will Jo Neely	
		Robert L. Hess	
TRACT ID	SURFACE OWNER	LESSOR	PIN
18B	David E. Van Scyoc	Three Rivers Royalty II, LLC	1-12-10.2
		WhiteHawk Income Marcellus LLC	
		David A. Joliffe and Donna Sue A. Joliffe	
		Lisa Ellen May and Gary A. May	
		Jeff T. Delaney	
		Martha A. Pryor a/k/a Martha Ann Pryor by Robert Owens as Agent	
		Lee E. Delaney	
		Joseph S. Delaney	
		Nancy Paulovicks and Jay E. Paulovicks, wife and husband	
		Michael S. Delaney	
		Earlene Owens and Robert Owens, wife and husband	
		W. James Shannon	
		Clarence Park and Linda S. Park, husband and wife	
		Linda L. Park	
		Nola Chisler and Charles D. Chisler, wife and husband	
		Jay Park and Carolyn S. Park, husband and wife	
		Martha Ann Prince	
		Mary Ellen Bell	
		Larry L. Delaney	
		Shawn Delaney	
		Charles R. Delaney	
		George William Cummins Jr	
		Hillary L. Clovis and Kristen Clovis, her wife	
		Jeremy J. Clovis and Wendy Clovis, his wife	
		Josh Clovis a/k/a Joshua Clovis and Chastity Clovis, his wife	
		Chelsa D. Kolb n/k/a Chelsa Hagedorn and Kevin Hagedorn, her husband	
		Rodney A. Clovis	
		Robin L. Clovis Wade, f/k/a Robin Lynn Clovis	
		Clinton Alan Clovis a/k/a Clint Clovis	
		Christopher Lance Clovis	
		Bruce Scott Carpenter and Patricia S. Carpenter, individually and as husband and wife	
		Patti Carpenter	
		Bruce P. Carpenter	
		Jeannine Osmanski and Robert E. Osmanski, individually and as husband and wife	
		Jack K. Lemley	
		NNE Properties II LLC	
		Will Jo Neely	
		Robert L. Hess	

08/28/2026

WDTN18HHSM CNX Gas Company LLC		PAGE 6 OF 9	
TRACT ID	SURFACE OWNER	LESSOR	PIN
18C	David E. Van Scyoc	Three Rivers Royalty II, LLC	1-12-32 1-12-33 1-12-34 p/o 1-12-34.1
		WhiteHawk Income Marcellus LLC	
		David A. Jolliffe and Donna Sue A. Jolliffe	
		Lisa Ellen May and Gary A. May	
		Jeff T. Delaney	
		Martha A. Pryor a/k/a Martha Ann Pryor by Robert Owens as Agent	
		Lee E. Delaney	
		Joseph S. Delaney	
		Nancy Paulovicks and Jay E. Paulovicks, wife and husband	
		Michael S. Delaney	
		Earlene Owens and Robert Owens, wife and husband	
		W. James Shannon	
		Clarence Park and Linda S. Park, husband and wife	
		Linda L. Park	
		Nola Chisler and Charles D. Chisler, wife and husband	
		Jay Park and Carolyn S. Park, husband and wife	
		Martha Ann Prince	
		Mary Ellen Bell	
		Larry L. Delaney	
		Shawn Delaney	
		Charles R. Delaney	
		George William Cummins Jr	
		Hillary L. Clovis and Kristen Clovis, her wife	
		Jeremy J. Clovis and Wendy Clovis, his wife	
		Josh Clovis a/k/a Joshua Clovis and Chestity Clovis, his wife	
		Chelsa D. Kolb n/k/a Chelsa Hagedorn and Kevin Hagedorn, her husband	
		Jack K. Lemley	
		Bruce Scott Carpenter and Patricia S. Carpenter, individually and as husband and wife	
		Patti Carpenter	
		Bruce P. Carpenter	
		Jeannine Osmanski and Robert E. Osmanski, individually and as husband and wife	
		Clinton Alan Clovis a/k/a Clint. Clovis	
		Christopher Lance Clovis	
		Rodney A. Clovis	
		Robin L. Clovis Wade, f/k/a Robin Lynn Clovis	
		NNE Properties II LLC	
		Willia Jo Neely	
		Robert L. Hess	
TRACT ID	SURFACE OWNER	LESSOR	PIN
71A	RDFS LLC	RDFS LLC	1-12-39
		Donna Maria Metzler a/k/a Donna Maria Scavariello	
		Pamela Marie Snuffer	
		Thomas G. Taylor	
		Karen Larew	
		Paul Eugene Booth a/k/a Paul E. Booth, Jr.	
		Ralph L. Taylor	
		Rosalee Riggs	
		Danny L. Booth	
		Rebecca Sue Cyrus f/k/a Rebecca Sue Poling	
		Ricky D. Litton	
		Gary L. Bedillon	
		David J. Stone	
		Thelma L. Coen	
		Larry K. Core	
		James M. Stone	
		Mary Ann Diddle	
		Samuel E. Litton	
		William Joseph Litton	
		Edward B. Entwisle, III	
		Karin L. Core	
		Linda Mae Wilkerson f/k/a Linda Mae Bunting	
		Mary Louise King f/k/a Mary Taylor	
		Kathy Cutwright Litton	
		Danny Clair Litton	
		Linda Darlene Litton	
		Ronald Irvin Kerr	
		Rachel Marie Hopkins	
		Bruce Entwisle a/k/a Bruce Entwisle Jr.	
		John William Taylor Sr. and Sarah Sue Taylor, husband and wife	
		Mark D. Shafer	
		Rebecca J. Boller	
		Cheri Loggains	
		Charles John Calder, III	
		Kimberly Bushka	
		Timothy Edward Calder	
		Hannah Diane Hopkins	
TRACT ID	SURFACE OWNER	LESSOR	PIN
71B	RDFS LLC	RDFS LLC	1-12-39.1
		Donna Maria Metzler a/k/a Donna Maria Scavariello	
		Pamela Marie Snuffer	
		Thomas G. Taylor	
		Karen Larew	
		Paul Eugene Booth a/k/a Paul E. Booth, Jr.	
		Ralph L. Taylor	
		Rosalee Riggs	
		Danny L. Booth	
		Rebecca Sue Cyrus f/k/a Rebecca Sue Poling	
		Ricky D. Litton	
		Gary L. Bedillon	
		David J. Stone	
		Thelma L. Coen	
		Larry K. Core	
		James M. Stone	
		Mary Ann Diddle	
		Samuel E. Litton	
		William Joseph Litton	
		Edward B. Entwisle, III	
		Karin L. Core	
		Linda Mae Wilkerson f/k/a Linda Mae Bunting	
		Mary Louise King f/k/a Mary Taylor	
		Kathy Cutwright Litton	
		Danny Clair Litton	
		Linda Darlene Litton	
		Ronald Irvin Kerr	
		Rachel Marie Hopkins	
		Bruce Entwisle a/k/a Bruce Entwisle Jr.	
		John William Taylor Sr. and Sarah Sue Taylor, husband and wife	
		Mark D. Shafer	
		Rebecca J. Boller	
		Cheri Loggains	
		Charles John Calder, III	
		Kimberly Bushka	
		Timothy Edward Calder	
		Hannah Diane Hopkins	

08/28/2026

TRACT ID	SURFACE OWNER	LESSOR	PIN
71C	RDFS LLC	RDFS LLC	1-12-39.2
		Donna Maria Metzler a/k/a Donna Maria Scavariello	
		Pamela Marie Snuffer	
		Thomas G. Taylor	
		Karen Larew	
		Paul Eugene Booth a/k/a Paul E. Booth, Jr.	
		Ralph L. Taylor	
		Rosalee Riggs	
		Danny L. Booth	
		Rebecca Sue Cyrus f/k/a Rebecca Sue Poling	
		Ricky D. Litton	
		Gary L. Bedillion	
		David J. Stone	
		Thelma L. Coen	
		Larry K. Core	
		James M. Stone	
		Mary Ann Diddle	
		Samuel E. Litton	
		William Joseph Litton	
		Edward B. Entwistle, III	
		Karin I. Core	
		Linda Mae Wilkerson f/k/a Linda Mae Bunting	
		Mary Louise King f/k/a Mary Taylor	
		Kathy Cutwright Litton	
		Danny Clair Litton	
		Linda Darlene Litton	
		Ronald Irvin Kerr	
		Rachel Marie Hopkins	
		Bruce Entwistle a/k/a Bruce Entwistle Jr.	
		John William Taylor Sr. and Sarah Sue Taylor, husband and wife	
		Mark D. Shafer	
		Rebecca J. Bolter	
		Cheri Loggains	
		Charles John Calder, III	
		Kimberly Bushka	
		Timothy Edward Calder	
		Hannah Diane Hopkins	
TRACT ID	SURFACE OWNER	LESSOR	PIN
72	Phyllis A. Bruce, et al	George Sanders	1-12-41
			1-12-43
			1-12-43.1
			1-13-9
			1-13-10.4
		Nancy Louise Walker	
		Leslie Dale Moore	
		Thomas W. Sanders	
		Patricia M. Sanders	
		Wayne C. McQuaid, Sr.	
		Sheryl Roesser	
		Shirley B. Cannon, by Melinda Cannon Kingbury, as Attorney-In-Fact	
		Armando W. Morales	
		Richard Lee Davisson	
		Mary Lynn Isling	
		Marjory L. Darwidi	
		Jan Davisson-Primmer	
		Jeanne Lou Hull	
		Baker Descendant Trust	
		Linda Stern a/k/a Linda Louise Stern	
		Mary Elizabeth Hartley	
		Corey Brandon Clemens Shuck	
		James B. Handlan	
		Stephen Howard Becker	
		Nicah Barrett Nevard and Elizabeth Ann Nevard, husband and wife	
		Michael P. Meehan	
TRACT ID	SURFACE OWNER	LESSOR	PIN
74	David E. Van Soyoc	Martha Sue Kerr	p/o 1-12-34.1
			1-12-35
			1-12-35.1
			1-12-35.3
		Larry A. Kerr	
		Bruce Scott Carpenter and Patricia S. Carpenter, individually and as husband and wife	
		Patti Carpenter	
		Bruce P. Carpenter	
		Jeannine Osmandski and Robert E. Osmandski, individually and as husband and wife	
		Jack K. Lemley	
		Bounty Minerals, LLC	
		Hillary L. Clovis and Kristen Clovis, her wife	
		Jeremy J. Clovis and Wendy Clovis, his wife	
		Josh Clovis a/k/a Joshua Clovis and Chastity Clovis, his wife	
		Chelsea D. Kolb n/k/a Chelsea Hagedorn and Kevin Hagedorn, her husband	
		Rodney A. Clovis	
		Robin L. Clovis Wade, f/k/a Robin Lynn Clovis	
		Clinton Alan Clovis a/k/a Clint Clovis	
		Christopher Lance Clovis	
		NNE Properties II LLC	
TRACT ID	SURFACE OWNER	LESSOR	PIN
86	Mark A. Shaver, et al	Suzanne Taylor	1-13-10
			1-13-10.3
			1-13-43.1
		April Rae Spears	
		Rachely Lynn Smith	
		Donna Lea Tennant	
		Heidi Kay Long	
		Jessica A. Tennant	
		Edward Nolan Brown	
		Julie Ann Luzader	
		Judy Kay Spears	
		Thaddeus T. Tennant	
		Heather Joy Spears Statler	
		Michael Taylor	
TRACT ID	SURFACE OWNER	LESSOR	PIN
92	CNX RCPC LLC	Terrance W. Mason	1-13-15
			1-13-15.1
			1-13-15.2
			1-13-15.3
		Debra L. Frazier	
TRACT ID	SURFACE OWNER	LESSOR	PIN
95	Norman Core, et al	Norman Core, Widower	1-18-1
			1-18-1.1
			1-18-2
		Deep Rock Mineral Group LLC	
		Northeast Natural Energy	
		EQT Production Company	
TRACT ID	SURFACE OWNER	LESSOR	PIN
96	John W. Jones, et al	Terrance W. Mason	1-13-15.3
		Debra L. Frazier	

08/28/2026

API WELL NO

47 - 061 - 02001

STATE COUNTY PERMIT

TRACT ID	SURFACE OWNER	LESSOR	PIN
106	John B. Koch, et al	Gary L. Truce, single John B. Koch, a married man, dealing with his sole and separate property Loretta Koch, widow Thomas W. Koch, single Paul V. Leach, a married man, dealing with his sole and separate property	1-18-23
111	Douglas T. Mercer, et ux	Masonic Charity Foundation of Oklahoma, f/k/a Most Worshipful Grand Lodge, Ancient Free and Accepted Masons of the State of Oklahoma William E. King and M. Cynthia Barnhart, Trustees of the John and Joann King Irrevocable Trust dated December 19, 2019 Joretta Garrison Pritchett Nancy Garrison Foster Patricia Garrison Foster Mary Garrison Miller LOLA Drilling I, LLC Rice Drilling B, LLC	1-18-35
112B	Thomas O. Brinegar III, et al	Thomas O. Brinegar, III and Susan A. Brinegar, husband and wife	1-18-33
112C	Thomas O. Brinegar III, et al	Thomas E. Walker and Shirley S. Walker, husband and wife Margaret E. Williams Charles R. Delaney George William Cummins, Jr Mike Ross, Inc Connie C. Sutton Donna C. Miller James A. Grimm Mark McCann and Patricia McCann, husband and wife Sarah G. Klucker and Robert L. Klucker, wife and husband Robert D. Gribbins and Felicia M. Gribbins, husband and wife Karin L. McKisson Marlene Kay Hyett John Richard Thralls Catherine M. Monell Lavere J. Mason Revocable Trust Melissa Dawson Josh Dawson Chad A. Wilson Mary Jane Shriver Henry E. Brewer Edward E. Brewer a/k/a Edward Brewer and Bonnie Brewer, husband and wife Billy L. Brewer a/k/a Billy Brewer and Barbara L. Brewer, husband and wife Janet L. Shiflet Linda L. Oswald f/k/a Linda L. Shimer Charles F. Phillips and Sara V. Phillips a/k/a Sara Phillips, husband and wife Randy D. Hanning Nicole R. Mattingly a/k/a Nikki Mattingly Shawn Delaney Sally Anne Byard Mercer a/k/a Sally Ann Mercer Jerry Francis Byard John Milush Carol Ann Byard Wilma Gale Parry Daniel J. Nabuda Kirchgesner Consulting Group, LLC Larry Delaney Stacey Mitchell Richard D. Repasky Julia M. Repasky Nicholas Parry Asa Earl Byard Constance Sue Whipkey Rush Michael Allen and Janis Allen, husband and wife Waymen W. Wilson, Jr. and Susan Wilson, husband and wife Samantha L. Rush Susan Rush Levelle and Robert Levelle, wife and husband Michelle Skaggs and John Skaggs, wife and husband Gretta Adams and Manson Adams, wife and husband Dan R. Haught a/k/a Danny Haught and Nancy Jane Haught, husband and wife Marguerite S. Eddy a/k/a Margie Eddy f/k/a Marguerite Temple Lee E. Delaney and Shannon Delaney, husband and wife Joseph S. Delaney Susan D. Delaney aka Susan Diane Delaney Michael S. Delaney and Susan Delaney, husband and wife William E. King and M. Cynthia Barnhart, Trustees of the John and Joann King Irrevocable Trust dated December 17, 2019 Deborah E. Page f/k/a Deborah E. Watson f/k/a Deborah Kisner and James R. Page, wife David G. Haught a/k/a David Haught and Martha Ann Haught, husband and wife T.J. Dawson a/k/a Travis Jack Dawson Bonnie Frattini Christina Parry f/k/a Christina Lincoln Gregory C. Mason Zachary L. Mason Betty Lou Dawson Senter Donald G. Dawson Dennis R. Haught Rebecca H. Cady a/k/a Rebecca Cady Christopher M. Mesler Northeast Natural Energy LLC EQT Production Company Northeast Natural Energy LLC Northeast Natural Energy LLC EQT Production Company	1-18-38
112D	Thomas O. Brinegar III, et al	Riff Hennen Northeast Natural Energy LLC NNE Properties LLC Northeast Natural Energy LLC EQT Production Company	1-18-34
114	CONSOL Mining Company LLC	Northeast Natural Energy LLC EQT Production Company	1-23-6
115	CONSOL Mining Company LLC	John E. Stankola	1-23-6

08/28/2026

TRACT ID	SURFACE OWNER	LESSOR	PIN
117	Betty J. Martino, et al	NNE Properties II LLC	1-23-9
		Ridgetop Appalachia LLC	
		Frank J. Failla, Jr	
		Sam Failla	
		Bernice T. Cook	
		The Geraldine Holmes Living Trust	
		Elizabeth Gaylene Owen	
		Janice Harris	
		Amanda Hollis	
		Kathy Ferguson Tidd	
		Peter R. Roseberry	
		Marlene L. Shirey a/k/a Marlene Shirey	
		Richard L. Sharp	
		Larene Welch	
		Steven L. Welch and Ellen B. Welch, his wife	
		Sonya R. Shrum	
		Northeast Natural Energy LLC	
		EQT Production Company	
		Shuman, Inc.	
		Northeast Natural Energy LLC	
		Northeast Natural Energy LLC	
		Northeast Natural Energy LLC	
		EQT Production Company	
		Equinor USA Onshore Properties Inc.	
		Northeast Natural Energy LLC	
		NNESP LLC	
		EQT Production Company	
		Miles Lee Holcomb a/k/a Miles Lee Halcomb	
		Unknown Heirs and Assigns of Gary D. Tennant	
		Roberta Ann Diggs Herman	
		Northeast Natural Energy LLC	
		Derick Allen Cox	
TRACT ID	SURFACE OWNER	LESSOR	PIN
118A	Sheila J. Tennant, et al	Sheila Jane Tennant	1-23-16
			1-23-16.2
			1-23-16.3
		Bounty Minerals, LLC	
		Shuman, Inc.	
		XTO Energy, Inc.	
TRACT ID	SURFACE OWNER	LESSOR	PIN
118C	Sheila J. Tennant, et al	Bounty Minerals, LLC	1-23-16.1
		Shuman, Inc.	
		RDFS LLC	
		XTO Energy, Inc.	

08/28/2026