



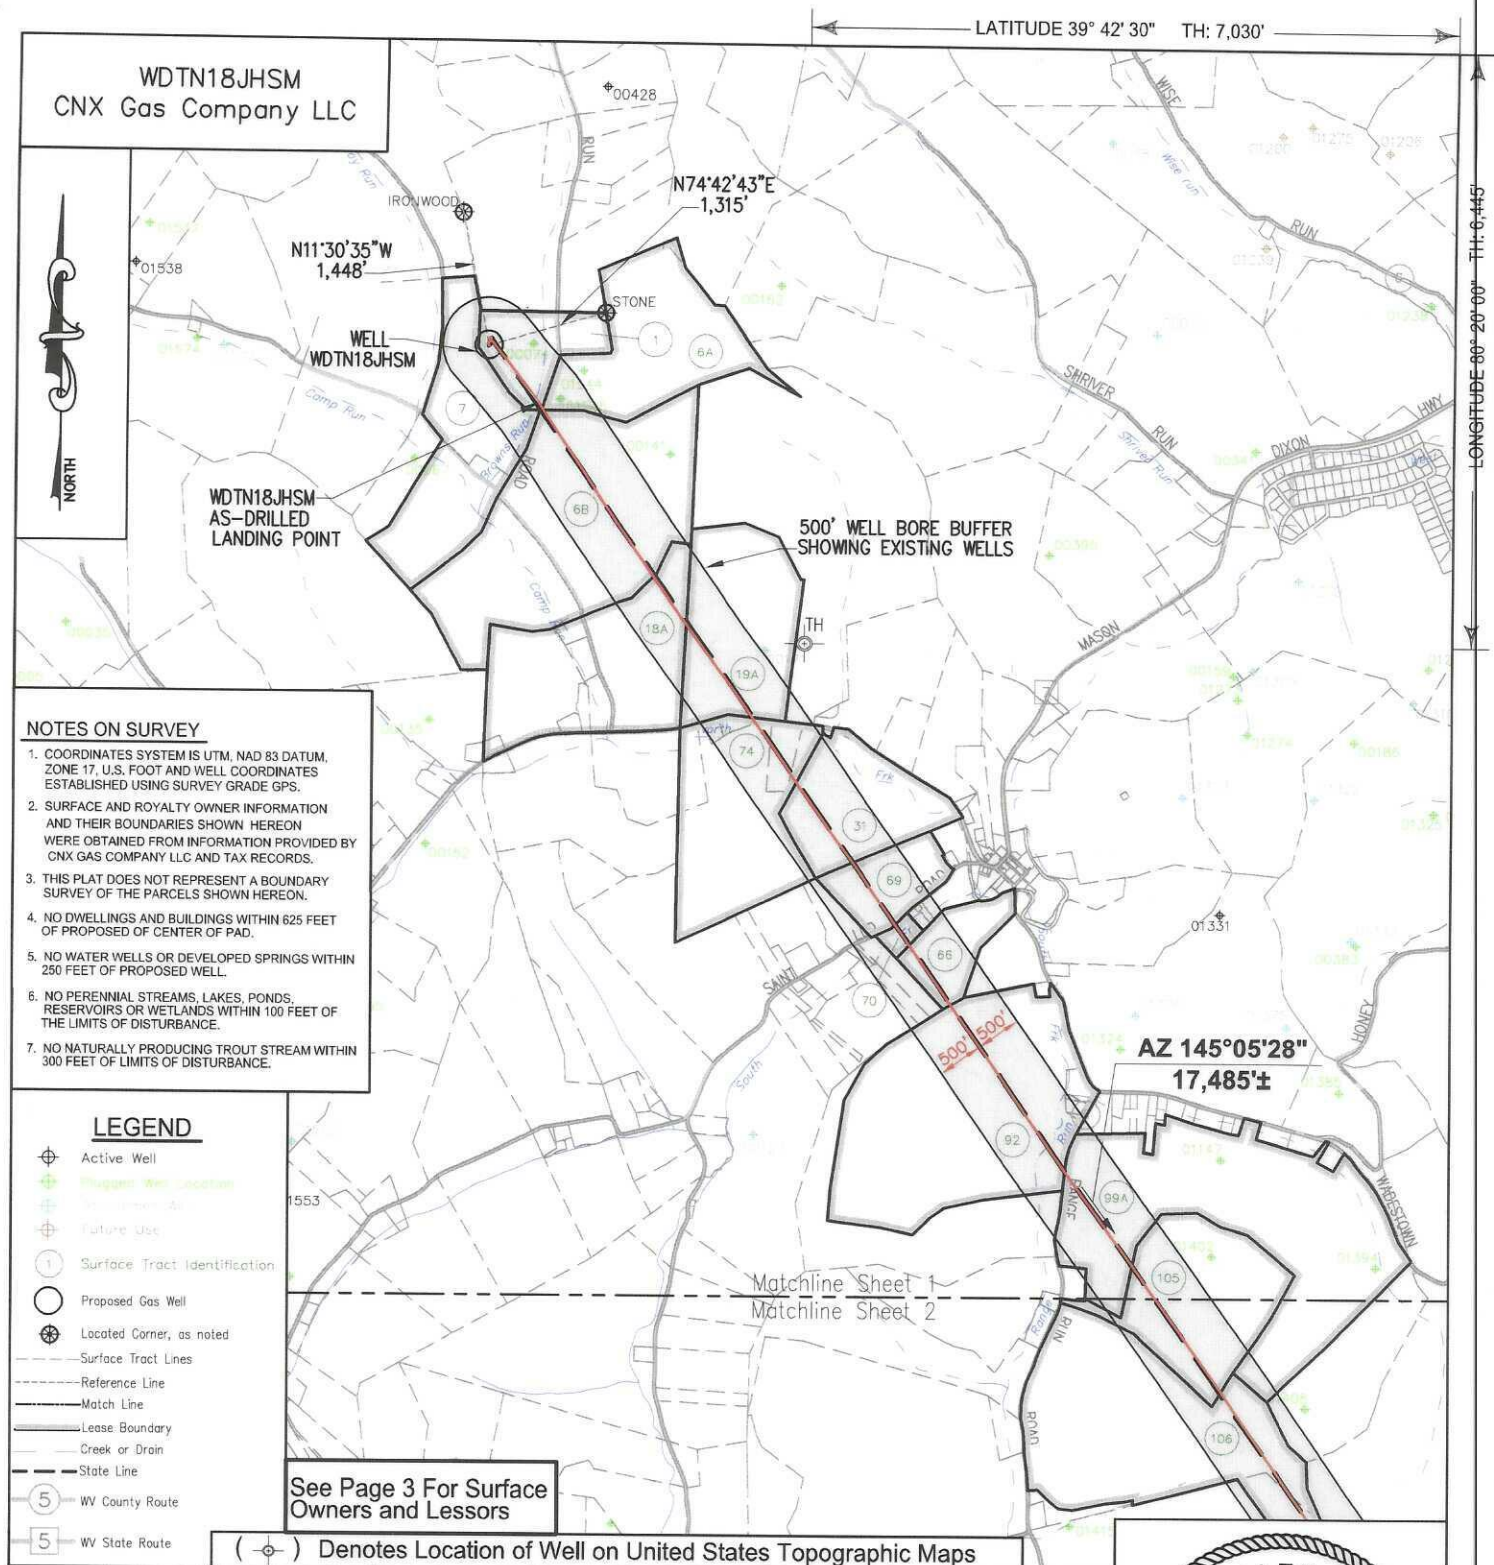


I, the undersigned, hereby certify that this plat is correct to the best of my knowledge and belief and shows all the information required by law and the regulations issued and prescribed by the Department of Environmental Protection.

L. L. S. 2394
L. L. S. 2394

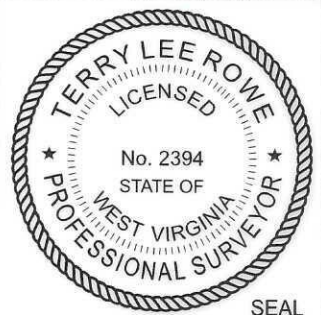

FILE NO:
DRAWING NO:
SCALE: 1" = 2000'
MINIMUM DEGREE OF ACCURACY:
1:2500
PROVEN SOURCE OF ELEVATION:
NGS CORS Station

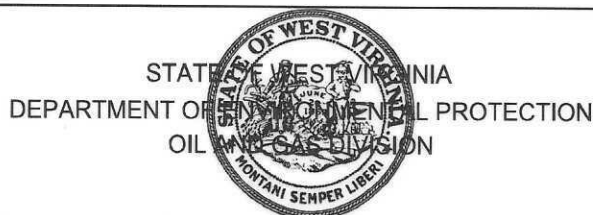

DATE: MARCH 20 20 26
OPERATORS WELL NO:
API WELL NO
47 - 061 - 02002
STATE COUNTY PERMIT

WELL TYPE: ☐ OIL ☒ GAS ☐ LIQUID INJECTION ☐ WASTE DISPOSAL
(IF GAS) PRODUCTION: ☐ STORAGE ☐ DEEP ☒ SHALLOW
LOCATION ELEVATION: 1199' WATERSHED: Dunkard Creek QUADRANGLE: Wadestown
DISTRICT: Battelle COUNTY: Monongalia
SURFACE OWNER: Consol Mining Company LLC ACREAGE: 46.75 ±
ROYALTY OWNER: Bounty Minerals, LLC LEASE NO: 189033000 ACREAGE: 59.02 ±
PROPOSED WORK: ☒ DRILL ☐ CONVERT ☐ DRILL DEEPER ☒ FRACTURE OR STIMULATE ☐ PLUG OFF OLD FORMATION
☐ PERFORATE NEW FORMATION ☐ OTHER PHYSICAL CHANGE IN WELL (SPECIFY)
☐ PLUG AND ABANDON ☐ CLEAN OUT AND REPLUG TARGET FORMATION: Marcellus ESTIMATED DEPTH: TVD: 7,847'

WELL OPERATOR: CNX Gas Company LLC
ADDRESS: 1000 Horizon Vue Drive
Canonsburg, PA 15317

DESIGNATED AGENT: Anthony Kendziora
ADDRESS: 111 Avondale Road
Fairmont, WV 26554

AS-DRILLED

WDTN18JHSM CNX Gas Company LLC		LATITUDE 39° 40' 00" BH: 8,075'	
		SHOWING EXISTING WELLS	
NOTES ON SURVEY - COORDINATES SYSTEM IS UTM, NAD 83 DATUM, ZONE 17, U.S. FOOT AND WELL COORDINATES ESTABLISHED USING SURVEY GRADE GPS. - SURFACE AND ROYALTY OWNER INFORMATION AND THEIR BOUNDARIES SHOWN HEREON WERE OBTAINED FROM INFORMATION PROVIDED BY CNX GAS COMPANY LLC AND TAX RECORDS. - THIS PLAT DOES NOT REPRESENT A BOUNDARY SURVEY OF THE PARCELS SHOWN HEREON. - NO DWELLINGS AND BUILDINGS WITHIN 625 FEET OF PROPOSED OF CENTER OF PAD. - NO WATER WELLS OR DEVELOPED SPRINGS WITHIN 250 FEET OF PROPOSED WELL. - NO PERENNIAL STREAMS, LAKES, PONDS, RESERVOIRS OR WETLANDS WITHIN 100 FEET OF THE LIMITS OF DISTURBANCE. - NO NATURALLY PRODUCING TROUT STREAM WITHIN 300 FEET OF LIMITS OF DISTURBANCE.		LEGEND - Active Well - Plugged Well Location - Well Location Data - Future Use - Surface Tract Identification - Proposed Gas Well - Located Corner, as noted - Surface Tract Lines - Reference Line - Match Line - Lease Boundary - Creek or Drain - State Line - WV County Route - WV State Route	
Matchline Sheet 1 Matchline Sheet 2		AZ 145°05'28" 17,485'±	
See Page 3 For Surface Owners and Lessors		() Denotes Location of Well on United States Topographic Maps	
		I, the undersigned, hereby certify that this plat is correct to the best of my knowledge and belief and shows all the information required by law and the regulations issued and prescribed by the Department of Environmental Protection. L. L. S. 2394	
FILE NO: _____ DRAWING NO: _____ SCALE: 1" = 2000' MINIMUM DEGREE OF ACCURACY: 1:2500 PROVEN SOURCE OF ELEVATION: NGS CORS Station		STATE OF WEST VIRGINIA DEPARTMENT OF ENVIRONMENTAL PROTECTION OIL AND GAS DIVISION	
WELL TYPE: ☐ OIL ☒ GAS ☐ LIQUID INJECTION ☐ WASTE DISPOSAL (IF GAS) PRODUCTION: ☐ STORAGE ☐ DEEP ☒ SHALLOW LOCATION ELEVATION: 1199' WATERSHED: Dunkard Creek QUADRANGLE: Wadestown DISTRICT: Battelle COUNTY: Monongalia SURFACE OWNER: Consol Mining Company LLC ACRES: 16.75 ± ROYALTY OWNER: Bounty Minerals, LLC LEASE NO: 189033000 ACRES: 59.02 ± PROPOSED WORK: ☒ DRILL ☐ CONVERT ☐ DRILL DEEPER ☒ FRACTURE OR STIMULATE ☐ PLUG OFF OLD FORMATION ☐ PERFORATE NEW FORMATION ☐ OTHER PHYSICAL CHANGE IN WELL (SPECIFY) ☐ PLUG AND ABANDON ☐ CLEAN OUT AND REPLUG TARGET FORMATION: Marcellus ESTIMATED DEPTH: TVD: 7,847'		DATE: MARCH 20 20 26 OPERATORS WELL NO: _____ API WELL NO 47 - 061 - 02002 STATE COUNTY PERMIT	
WELL OPERATOR: CNX Gas Company LLC ADDRESS: 1000 Horizon Vue Drive Canonsburg, PA 15317		DESIGNATED AGENT: Anthony Kendziora ADDRESS: 111 Avondale Road Fairmont, WV 26554	

AS-DRILLED

WDTN18JHSM
CNX Gas Company LLC

PAGE 3 OF 8

TRACT ID	SURFACE OWNER	LESSOR	PIN
1	Consol Mining Company LLC	Eastern Associated Coal Corporation	1-9-38 1-9-37
TRACT ID	SURFACE OWNER	LESSOR	PIN
6A	CONSOL Mining Company LLC	Virgie Shriver, et al Eastern Associated Coal Crop. CNX Gas Company LLC Consolidation Coal Company	1-12-8
TRACT ID	SURFACE OWNER	LESSOR	PIN
6B	CONSOL Mining Company LLC	Virgie Shriver, et al Eastern Associated Coal Crop. CNX Gas Company LLC Consolidation Coal Company	1-12-8
TRACT ID	SURFACE OWNER	LESSOR	PIN
7	Consol Mining Company LLC	Bounty Minerals, LLC Bounty Minerals III Acquisitions, LLC LOLA Drilling I, LLC Rice Drilling B, LLC	1-9-37 1-12-7
TRACT ID	SURFACE OWNER	LESSOR	PIN
18A	David E. Van Soyoc	Three Rivers Royalty II, LLC WhiteHawk Income Marcellus LLC David A. Jolliffe and Donna Sue A. Jolliffe Lisa Ellen May and Gary A. May Jeff T. Delaney Martha A. Pryor a/k/a Martha Ann Pryor by Robert Owens as Agent Lee E. Delaney Joseph S. Delaney Nancy Paulovicks and Jay E. Paulovicks, wife and husband Michael S. Delaney Earlene Owens and Robert Owens, wife and husband W. James Shannon Clarence Park and Linda S. Park, husband and wife Linda L. Park Nola Chisler and Charles D. Chisler, wife and husband Jay Park and Carolyn S. Park, husband and wife Martha Ann Prince Mary Ellen Bell Larry L. Delaney Shawn Delaney Charles R. Delaney George William Cummins Jr Hillary L. Clovis and Kristen Clovis, her wife Jeremy J. Clovis and Wendy Clovis, his wife Josh Clovis a/k/a Joshua Clovis and Chastity Clovis, his wife Chelse D. Kolb a/k/a Chelse Hagedorn and Kevin Hagedorn, her husband Rodney A. Clovis Robin L. Clovis Wade, f/k/a Robin Lynn Clovis Clinton Allen Clovis a/k/a Clint Clovis Christopher Lemco Clovis Bruce Scott Carpenter and Patricia S. Carpenter, individually and as husband and wife Patti Carpenter Bruce P. Carpenter Jeannine Osmanski and Robert E. Osmanski, individually and as husband and wife NNE Properties II LLC Willia Jo Neely Robert L. Hess	1-12-10 1-12-10.1 1-12-11 1-12-11.1 1-12-11.2 1-12-11.3

WDTN18JHSM

2500'

1" = 2000'

Well References

N47°02'08"E
523'

REFERENCE STAKE

S21°25'20"E
483'

REFERENCE STAKE

WDTN18JHSM

1" = 1500'

SURFACE HOLE LOCATION (SHL)

UTM 17 NAD 83
N: 4393618.62
E: 555020.62

NAD 83, WV NORTH
N: 434819.106
E: 1726968.024

LAT/LON DATUM NAD 83
LAT: 39°41'26.293"
LON: 80°21'29.935"

LANDING POINT
UTM 17 NAD 83
N: 4393432.67
E: 555188.87

NAD 83, WV NORTH
N: 434199.722
E: 1727509.895

LAT/LON DATUM NAD 83
LAT: 39°41'20.222"
LON: 80°21'22.927"

WDTN18 WELL PAD

WDTN18HHSM ○ ○ WDTN18JHSM
WDTN18GHSM ○ ○ WDTN18KHSM
WDTN18FHSM ○ ○ WDTN18VHSM

BOTTOM HOLE LOCATION (BHL)

UTM 17 NAD 83
N: 4389115.29
E: 558310.01

NAD 83, WV NORTH
N: 419861.726
E: 1737514.854

LAT/LON DATUM NAD 83
LAT: 39°38'59.442"
LON: 80°19'13.269"

KEYSTONE
CONSULTANTS, LLC

I, the undersigned, hereby certify that this plat is correct to the best of my knowledge and belief and shows all the information required by law and the regulations issued and prescribed by the Department of Environmental Protection.

L. L. S. 2394

Seal of Terry Lee Rowe, Licensed Professional Surveyor, No. 2394, State of West Virginia

FILE NO:
DRAWING NO:
SCALE: 1" = 1000'
MINIMUM DEGREE OF ACCURACY:
1:2500
PROVEN SOURCE OF ELEVATION:
NGS CORS Station

STATE OF WEST VIRGINIA
DEPARTMENT OF ENVIRONMENTAL PROTECTION
OIL AND GAS DIVISION

DATE: MARCH 20 20 26
OPERATORS WELL NO:
API WELL NO
47 - 061 - 02002
STATE COUNTY PERMIT

WELL TYPE: ☐ OIL ☒ GAS ☐ LIQUID INJECTION ☐ WASTE DISPOSAL
(IF GAS) PRODUCTION: ☐ STORAGE ☐ DEEP ☒ SHALLOW
LOCATION ELEVATION: 1199' WATERSHED: Dunkard Creek QUADRANGLE: Wadestown
DISTRICT: Battelle COUNTY: Monongalia
SURFACE OWNER: Consol Mining Company LLC ACRES: 46.75 ±
ROYALTY OWNER: Bounty Minerals, LLC LEASE NO: 189033000 ACRES: 59.02 ±
PROPOSED WORK: ☒ DRILL ☐ CONVERT ☐ DRILL DEEPER ☒ FRACTURE OR STIMULATE ☐ PLUG OFF OLD FORMATION
☐ PERFORATE NEW FORMATION ☐ OTHER PHYSICAL CHANGE IN WELL (SPECIFY)
☐ PLUG AND ABANDON ☐ CLEAN OUT AND REPLUG TARGET FORMATION: Marcellus ESTIMATED DEPTH: TVD: 7,847'
WELL OPERATOR: CNX Gas Company LLC DESIGNATED AGENT: Anthony Kendziora
ADDRESS: 1000 Horizon Vue Drive ADDRESS: 111 Avondale Road
Canonsburg, PA 15317 Fairmont, WV 26554

AS-DRILLED

TRACT ID	SURFACE OWNER	LESSOR	PIN
19A	Ralph Six	Bounty Minerals, LLC	1-12-9
		Bounty Minerals III Acquisitions, LLC	
		LOLA Drilling 1, LLC	
		Rice Drilling B, LLC	
		Rice Drilling B, LLC	
		SWS Holding LLC	
TRACT ID	SURFACE OWNER	LESSOR	PIN
31	John and Joann King Irrevocable Trust	Debra Lynn Lundgren	1-13-7
		EQT Production Company	
TRACT ID	SURFACE OWNER	LESSOR	PIN
66	Jessica L. Waddell, et al	Bounty Minerals LLC	1-13-11
TRACT ID	SURFACE OWNER	LESSOR	PIN
69	John and Joann King Irrevocable Trust	Greg Shriver, Successor Trustee for the benefit of West Warren Baptist Church under the Last Will and Testament of Blanche C. Shriver, and Greg Shriver, Norman Core and Rick Wolfe, Trustees of the West Warren Baptist Church	1-13-8
TRACT ID	SURFACE OWNER	LESSOR	PIN
70	Roger Leo Wade, et ux	Bula Baptist Church by its Trustees, George Sanders, Randy Stiles, Francis Haught and Delbert Corder	1-13A-1
		Union Baptist Church by its Trustees, Roy Dale Chisler and Jackie Miller	
		West Warren Baptist Church by its Trustees, Greg Shriver, Norman Core, and Tom Sanders	
TRACT ID	SURFACE OWNER	LESSOR	PIN
74	David E. Van Scyoc	Martha Sue Kerr	p/o 1-12-34.1
			1-12-35
			1-12-35.1
			1-12-35.3
		Larry A. Kerr	
		Bruce Scott Carpenter and Patricia S. Carpenter, individually and as husband and wife	
		Patti Carpenter	
		Bruce P. Carpenter	
		Jeannine Osmanski and Robert E. Osmanski, individually and as husband and wife	
		Jack K. Lemley	
		Bounty Minerals, LLC	
		Hillary L. Clovis and Kristen Clovis, her wife	
		Jeremy J. Clovis and Wendy Clovis, his wife	
		Josh Clovis a/k/a Joshua Clovis and Chastity Clovis, his wife	
		Chelsa D. Kolb n/k/a Chelsa Hagedorn and Kevin Hagedorn, her husband	
		Rodney A. Clovis	
		Robin L. Clovis Wade, f/k/a Robin Lynn Clovis	
		Clinton Alan Clovis a/k/a Clint Clovis	
		Christopher Lance Clovis	
		NNE Properties II LLC	
		Willa Jo Neely	
		Robert L. Hess	
TRACT ID	SURFACE OWNER	LESSOR	PIN
92	CNX RPCC LLC	Terrance W. Mason	1-13-15
			1-13-15.1
			1-13-15.2
			1-13-15.3
		Debra L. Frazier	
TRACT ID	SURFACE OWNER	LESSOR	PIN
99A	Betty S. Baird	William E. King and M. Cynthia Barnhart, Trustees of the John and Joann King Irrevocable Trust dated December 19, 2019	1-18-3
		Masonic Charity Foundation of Oklahoma f/k/a Most Worshipful Grand Lodge of Ancient Free and Accepted Masons of the State of Oklahoma	
		Northeast Natural Energy LLC	
		EQT Production Company	
TRACT ID	SURFACE OWNER	LESSOR	PIN
105	Betty S. Baird	Northeast Natural Energy LLC	1-18-23.3
		EQT Production Company	
TRACT ID	SURFACE OWNER	LESSOR	PIN
106	John B. Koch, et al	Gary L. Truce, single	1-18-23
		John B. Koch, a married man, dealing with his sole and separate property	
		Loretta Koch, widow	
		Thomas W. Koch, single	
		Paul V. Leach, a married man, dealing with his sole and separate property	

08/28/2026

TRACT ID	SURFACE OWNER	LESSOR	PIN
112C	Thomas O. Brinegar III, et al	Thomas E. Walker and Shirley S. Walker, husband and wife	1-18-38
		Margaret E. Williams	
		Charles R. Delaney	
		George William Cummins, Jr	
		Mike Ross, Inc	
		Connie C. Sutton	
		Donna C. Miller	
		James A. Grimm	
		Mark McCann and Patricia McCann, husband and wife	
		Sarah G. Klucker and Robert L. Klucker, wife and husband	
		Robert D. Gribbins and Felicia M. Gribbins, husband and wife	
		Karin L. McKisson	
		Marlene Kay Hyett	
		John Richard Thralls	
		Catherine M. Monell	
		Lavere J. Mason Revocable Trust	
		Melissa Dawson	
		Josh Dawson	
		Chad A. Wilson	
		Mary Jane Shriver	
		Henry E. Brewer	
		Edward E. Brewer a/k/a Edward Brewer and Bonnie Brewer, husband and wife	
		Billy L. Brewer a/k/a Billy Brewer and Barbara L. Brewer, husband and wife	
		Janet L. Shiflet	
		Linda L. Oswald f/k/a Linda L. Shimer	
		Charles F. Phillips and Sara V. Phillips a/k/a Sara Phillips, husband and wife	
		Randy D. Hanning	
		Nicole R. Mattingly a/k/a Nikki Mattingly	
		Shawn Delaney	
		Sally Anne Byard Mercer a/k/a Sally Ann Mercer	
		Jerry Francis Byard	
		John Milush	
		Carol Ann Byard	
		Wilma Gale Parry	
		Daniel J. Nabuda	
		Kirchgessner Consulting Group, LLC	
		Larry Delaney	
		Stacey Mitchell	
		Richard D. Repasky	
		Julia M. Repasky	
		Nicholas Parry	
		Asa Earl Byard	
		Constance Sue Whipkey Rush	
		Michael Allen and Janis Allen, husband and wife	
		Waymen W. Wilson, Jr. and Susan Wilson, husband and wife	
		Samantha L. Rush	
		Susan Rush Levelle and Robert Levelle, wife and husband	
		Michelle Skaggs and John Skaggs, wife and husband	
		Gretta Adams and Manson Adams, wife and husband	
		Dan R. Haught a/k/a Danny Haught and Nancy Jane Haught, husband and wife	
		Marguerite S. Eddy a/k/a Margie Eddy f/k/a Marguerite Temple	
		Lee E. Delaney and Shannon Delaney, husband and wife	
		Joseph S. Delaney	
		Susan D. Delaney aka Susan Diane Delaney	
		Michael S. Delaney and Susan Delaney, husband and wife	
		William E. King and M. Cynthia Barnhart, Trustees of the John and Joann King Irrevocable Trust dated December 17, 2019	
		Deborah E. Page f/k/a Deborah E. Watson f/k/a Deborah Kisner and James R. Page, wife and husband	
		David G. Haught a/k/a David Haught and Martha Ann Haught, husband and wife	
		T.J. Dawson a/k/a Travis Jack Dawson	
		Bonnie Frattini	
		Christina Parry f/k/a Christina Lincoln	
		Gregory C. Mason	
		Zachary L. Mason	
		Betty Lou Dawson Senter	
		Donald G. Dawson	
		Dennis R. Haught	
		Rebecca H. Cady a/k/a Rebecca Cady	
		Chistopher M. Mesler	
		Northeast Natural Energy LLC	
		EQT Production Company	
		EQT Production Company	
		Northeast Natural Energy LLC	
		Northeast Natural Energy LLC	
		EQT Production Company	
		EQT Production Company	

08/28/2026

TRACT ID	SURFACE OWNER	LESSOR	PIN
112E	Thomas O. Brinegar III, et al	Thomas E. Walker and Shirley S. Walker, husband and wife	1-18-36
TRACT ID	SURFACE OWNER	LESSOR	PIN
112G	Thomas O. Brinegar III, et al	Thomas E. Walker and Shirley S. Walker, husband and wife	1-18-39
		Margaret E. Williams	
		Charles R. Delaney	
		George William Cummins, Jr	
		Mike Ross, Inc	
		James A. Grimm	
		Mark McCann and Patricia McCann, husband and wife	
		Sarah G. Klucker and Robert L. Klucker, wife and husband	
		Robert D. Gribbins and Felicia M. Gribbins, husband and wife	
		Karin L. McKisson	
		Marlene Kay Hyett	
		John Richard Thralls	
		Catherine M. Monell	
		Lavere J. Mason Revocable Trust	
		Melissa Dawson	
		Josh Dawson	
		Chad A. Wilson	
		Mary Jane Shriver	
		Henry E. Brewer	
		Edward E. Brewer a/k/a Edward Brewer and Bonnie Brewer, husband and wife	
		Billy L. Brewer a/k/a Billy Brewer and Barbara L. Brewer, husband and wife	
		Janet L. Shiflet	
		Linda L. Oswald f/k/a Linda L. Shimer	
		Charles F. Phillips and Sara V. Phillips a/k/a Sara Phillips, husband and wife	
		Randy D. Hanning	
		Nicole R. Mattingly a/k/a Nikki Mattingly	
		Shawn Delaney	
		Sally Anne Byard Mercer a/k/a Sally Ann Mercer	
		Jerry Francis Byard	
		John Milush	
		Carol Ann Byard	
		Wilma Gale Parry	
		Daniel J. Nabuda	
		Kirchgessner Consulting Group, LLC	
		Larry Delaney	
		Stacey Mitchell	
		Richard D. Repasky	
		Julia M. Repasky	
		Nicholas Parry	
		Asa Earl Byard	
		Constance Sue Whipkey Rush	
		Michael Allen and Janis Allen, husband and wife	
		Waymen W. Wilson, Jr. and Susan Wilson, husband and wife	
		Samantha L. Rush	
		Susan Rush Levelle and Robert Levelle, wife and husband	
		Michelle Skaggs and John Skaggs, wife and husband	
		Gretta Adams and Manson Adams, wife and husband	
		Dan R. Haught a/k/a Danny Haught and Nancy Jane Haught, husband and wife	
		Marguerite S. Eddy a/k/a Margie Eddy f/k/a Marguerite Temple	
		Lee E. Delaney and Shannon Delaney, husband and wife	
		Joseph S. Delaney	
		Susan D. Delaney aka Susan Diane Delaney	
		Michael S. Delaney and Susan Delaney, husband and wife	
		William E. King and M. Cynthia Barnhart, Trustees of the John and Joann King Irrevocable Trust dated December 17, 2019	
		Deborah E. Page f/k/a Deborah E. Watson f/k/a Deborah Kisner and James R. Page, wife and husband	
		David G. Haught a/k/a David Haught and Martha Ann Haught, husband and wife	
		T.J. Dawson a/k/a Travis Jack Dawson	
		Jason Ratliff	
		Bonnie Frattini	
		Christina Parry f/k/a Christina Lincoln	
		Gregory C. Mason	
		Zachary L. Mason	
		Betty Lou Dawson Senter	
		Donald G. Dawson	
		Dennis R. Haught	
		Rebecca H. Cady a/k/a Rebecca Cady	
		Christopher M. Mesler	
		Connie C. Sutton	
		Donna C. Miller	
		Quentin Dale Knight	
		Northeast Natural Energy LLC	
		EQT Production Company	
		Northeast Natural Energy LLC	
		Northeast Natural Energy LLC	
		EQT Production Company	

08/28/2026

TRACT ID	SURFACE OWNER	LESSOR	PIN
112H	Thomas O. Brinegar III, et al	Thomas E. Walker and Shirley S. Walker, husband and wife	1-18-39
		Margaret E. Williams	
		Charles R. Delaney	
		George William Cummins, Jr	
		Mike Ross, Inc	
		James A. Grimm	
		Mark McCann and Patricia McCann, husband and wife	
		Sarah G. Klucker and Robert L. Klucker, wife and husband	
		Robert D. Gribbins and Felicia M. Gribbins, husband and wife	
		Karin L. McKisson	
		Marlene Kay Hyett	
		John Richard Thralls	
		Catherine M. Monell	
		Lavere J. Mason Revocable Trust	
		Melissa Dawson	
		Josh Dawson	
		Chad A. Wilson	
		Mary Jane Shriver	
		Henry E. Brewer	
		Edward E. Brewer a/k/a Edward Brewer and Bonnie Brewer, husband and wife	
		Billy L. Brewer a/k/a Billy Brewer and Barbara L. Brewer, husband and wife	
		Janet L. Shiflet	
		Linda L. Oswald f/k/a Linda L. Shimer	
		Charles F. Phillips and Sara V. Phillips a/k/a Sara Phillips, husband and wife	
		Randy D. Hanning	
		Nicole R. Mattingly a/k/a Nikki Mattingly	
		Shawn Delaney	
		Sally Anne Byard Mercer a/k/a Sally Ann Mercer	
		Jerry Francis Byard	
		John Milush	
		Carol Ann Byard	
		Wilma Gale Parry	
		Daniel J. Nabuda	
		Kirchgeßner Consulting Group, LLC	
		Larry Delaney	
		Stacey Mitchell	
		Richard D. Repasky	
		Julia M. Repasky	
		Nicholas Parry	
		Asa Earl Byard	
		Constance Sue Whipkey Rush	
		Michael Allen and Janis Allen, husband and wife	
		Waymen W. Wilson, Jr. and Susan Wilson, husband and wife	
		Samantha L. Rush	
		Susan Rush Levelle and Robert Levelle, wife and husband	
		Michelle Skaggs and John Skaggs, wife and husband	
		Gretta Adams and Manson Adams, wife and husband	
		Dan R. Haught a/k/a Danny Haught and Nancy Jane Haught, husband and wife	
		Marguerite S. Eddy a/k/a Margie Eddy f/k/a Marguerite Temple	
		Lee E. Delaney and Shannon Delaney, husband and wife	
		Joseph S. Delaney	
		Susan D. Delaney aka Susan Diane Delaney	
		Michael S. Delaney and Susan Delaney, husband and wife	
		William E. King and M. Cynthia Barnhart, Trustees of the John and Joann King Irrevocable Trust dated December 17, 2019	
		Deborah E. Page f/k/a Deborah E. Watson f/k/a Deborah Kisner and James R. Page, wife and husband	
		David G. Haught a/k/a David Haught and Martha Ann Haught, husband and wife	
		T.J. Dawson a/k/a Travis Jack Dawson	
		Jason Ratliff	
		Bonnie Frattini	
		Christina Parry f/k/a Christina Lincoln	
		Northeast Natural Energy LLC	
		Gregory C. Mason	
		Zachary L. Mason	
		Betty Lou Dawson Senter	
		Donald G. Dawson	
		Dennis R. Haught	
		Rebecca H. Cady a/k/a Rebecca Cady	
		Chistopher M. Mesler	
		Connie C. Sutton	
		Donna C. Miller	
		Quentin Dale Knight	
		Northeast Natural Energy LLC	

08/28/2026

TRACT ID	SURFACE OWNER	LESSOR	PIN
114	CONSOL Mining Company LLC	Northeast Natural Energy LLC	1-23-6
		EQT Production Company	
TRACT ID	SURFACE OWNER	LESSOR	PIN
127	James Sheets	Kathryn H. Gordon	1-18-41
		Northeast Natural Energy LLC	

08/28/2026