

4706102044


RECEIVED
Office of Oil and Gas

MAY 13 2026

WV Department of
Environmental Protection

06/26/2026



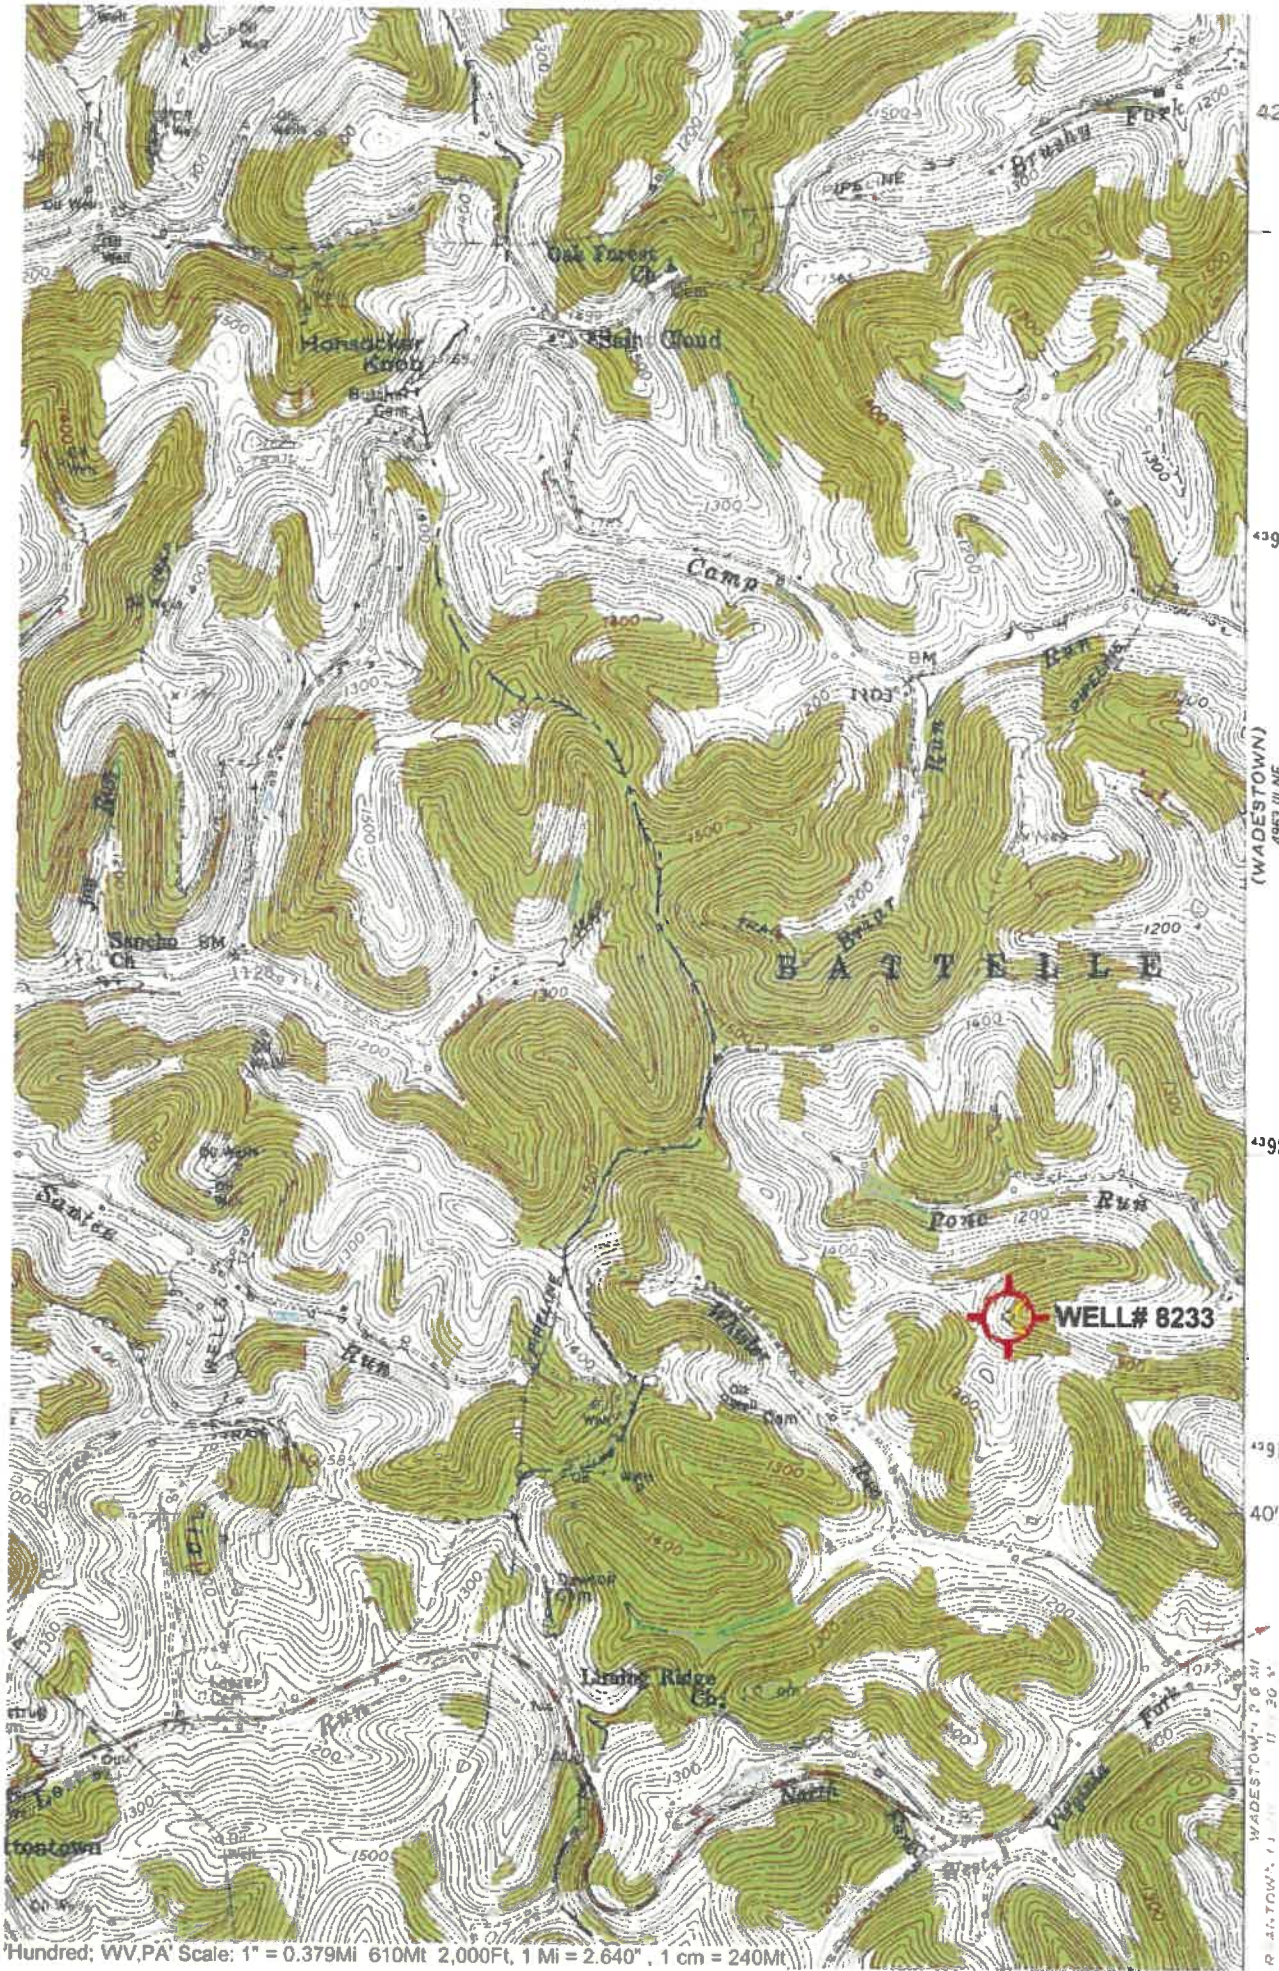

Hundred; WV,PA Scale: 1" = 0.379Mi 610Mt 2,000Ft, 1 Mi = 2.640", 1 cm = 240Mt

470610204P

RECEIVED
Office of Oil and Gas

MAY 13 2026

WV Department of
Environmental Protection

06/26/2026

WW-7
8-30-06



4706102044P

RECEIVED
Office of Oil and Gas

MAY 13 2026

WV Department of
Environmental Protection

West Virginia Department of Environmental Protection
Office of Oil and Gas

WELL LOCATION FORM: GPS

API: 47-061-30001 WELL NO.: 8233
FARM NAME: Jackson Kennedy #5356
RESPONSIBLE PARTY NAME: WEST VIRGINIA LAND RESOURCES INC.
COUNTY: Monongalia DISTRICT: Battelle
QUADRANGLE: Hundred, WV
SURFACE OWNER: Kenneth L. Glover Jr.
ROYALTY OWNER: _____
UTM GPS NORTHING: 4,391,603 m
UTM GPS EASTING: 552,848 m GPS ELEVATION: 394 m (1292 FT)

The Responsible Party named above has chosen to submit GPS coordinates in lieu of preparing a new well location plat for a plugging permit or assigned API number on the above well. The Office of Oil and Gas will not accept GPS coordinates that do not meet the following requirements:

1. Datum: NAD 1983, Zone: 17 North, Coordinate Units: meters, Altitude: height above mean sea level (MSL) – meters.
2. Accuracy to Datum – 3.05 meters
3. Data Collection Method:

Survey grade GPS X : Post Processed Differential X

Real-Time Differential _____

Mapping Grade GPS _____ : Post Processed Differential _____

Real-Time Differential _____

4. Letter size copy of the topography map showing the well location.

I the undersigned, hereby certify this data is correct to the best of my knowledge and belief and shows all the information required by law and the regulations issued and prescribed by the Office of Oil and Gas.

Signature

PS 2002

Title

April 28, 2026

Date

06/26/2026