

WW-7
8-30-06



West Virginia Department of Environmental Protection
Office of Oil and Gas

WELL LOCATION FORM: GPS

API: 47-103-00841 WELL NO.: WV 601769

FARM NAME: Hubbard

RESPONSIBLE PARTY NAME: Equitrans L.P.

COUNTY: Wetzel DISTRICT: Grant

QUADRANGLE: Big Run

SURFACE OWNER: John Michael Byard

ROYALTY OWNER: Liberty Holding Company

UTM GPS NORTHING: 4383111.9

UTM GPS EASTING: 537706.5 GPS ELEVATION: 980'

The Responsible Party named above has chosen to submit GPS coordinates in lieu of preparing a new well location plat for a plugging permit or assigned API number on the above well. The Office of Oil and Gas will not accept GPS coordinates that do not meet the following requirements:

1. Datum: NAD 1983, Zone: 17 North, Coordinate Units: meters, Altitude: height above mean sea level (MSL) – meters.
2. Accuracy to Datum – 3.05 meters
3. Data Collection Method:

Survey grade GPS : Post Processed Differential

Real-Time Differential

Mapping Grade GPS : Post Processed Differential

Real-Time Differential

Received

AUG - 7 2014

4. Letter size copy of the topography map showing the well location.

I the undersigned, hereby certify this data is correct to the best of my knowledge and belief and shows all the information required by law and the regulations issued and prescribed by the Office of Oil and Gas.

Ann D. Hall
Signature

Sr. Storage Specialist
Title

7/23/2014
Date

Office of Oil and Gas
WV Dept. of Environmental Protection

Topo Quad: Big Run

Scale: 1" to 2000'

County: Wetzel


Date: 7-24-2014

District: Grant

Project No: _____

Water

47-103-00841 (WV 601769)

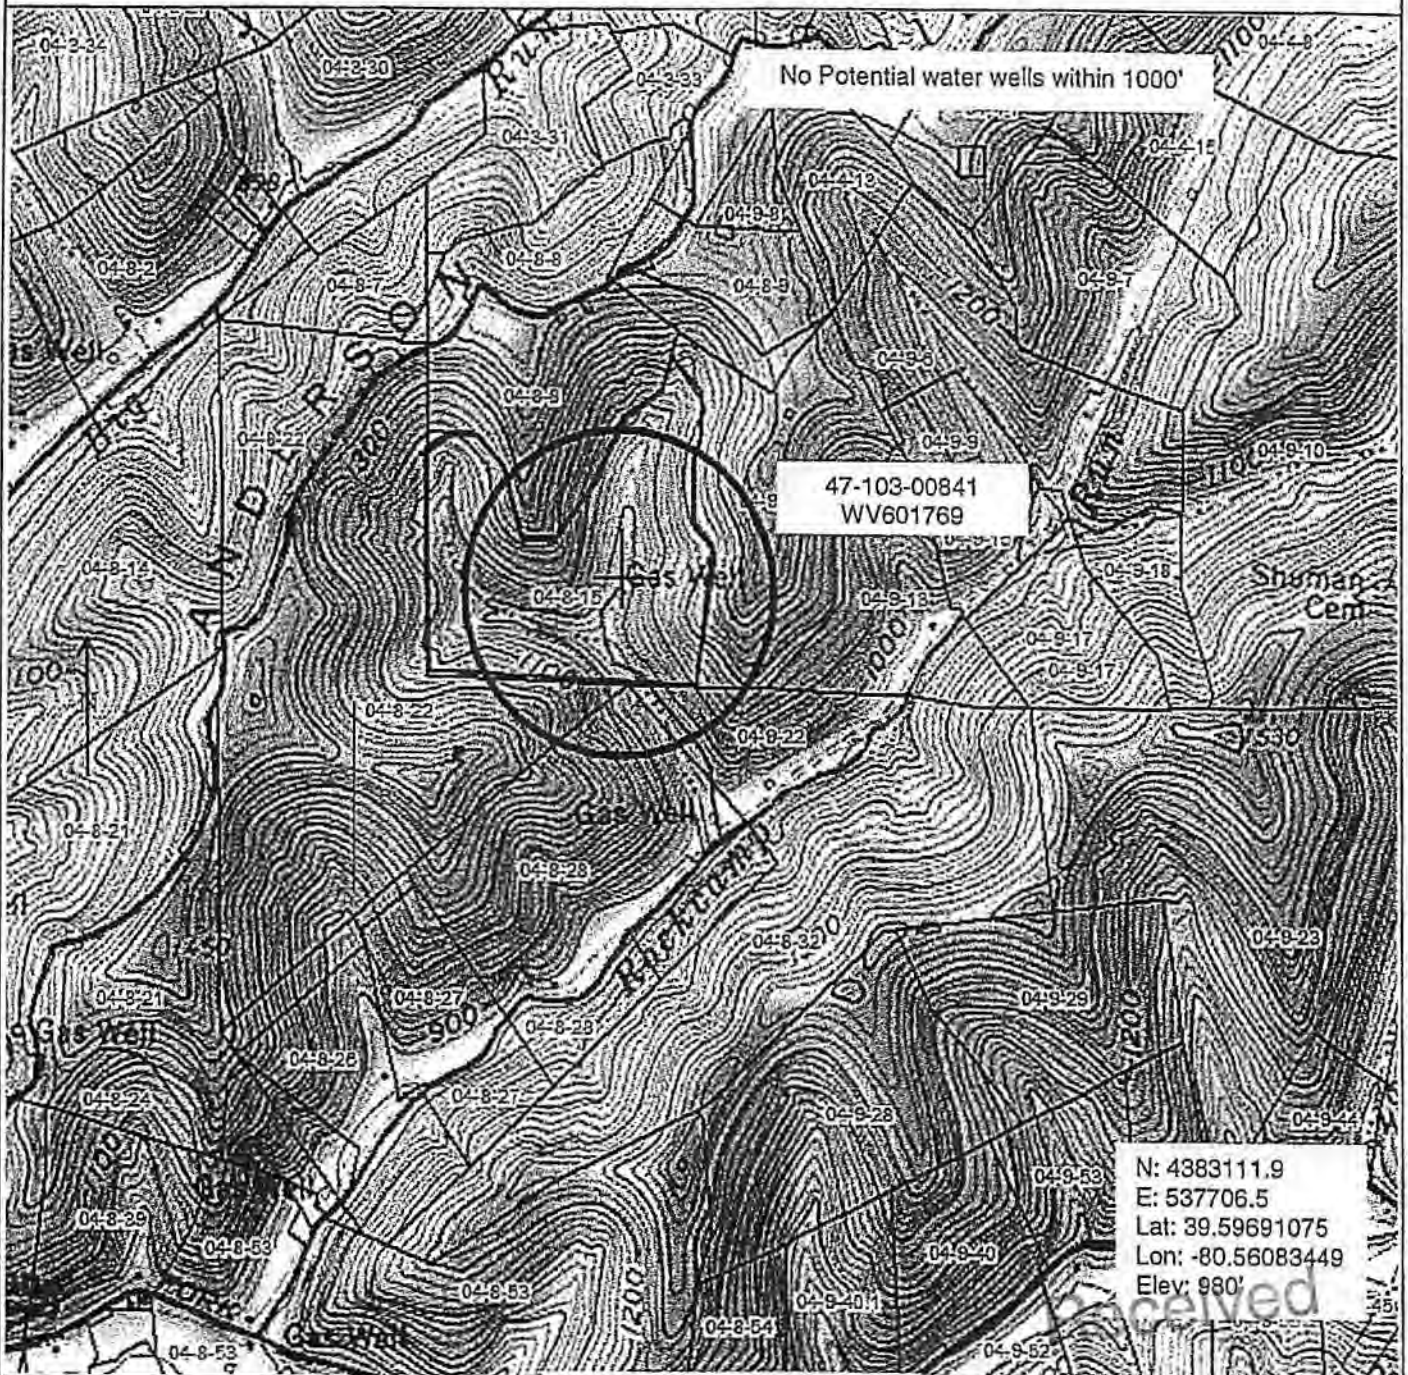

N: 4383111.9
E: 537706.5
Lat: 39.59691075
Lon: -80.56083449
Elev: 980'

Equitrans L. P.

303 Sand Cut Road
Clarksburg, WV 26301

PMH AUG - 7 2014
8-4-14

Office of Oil and Gas
Environmental Protection