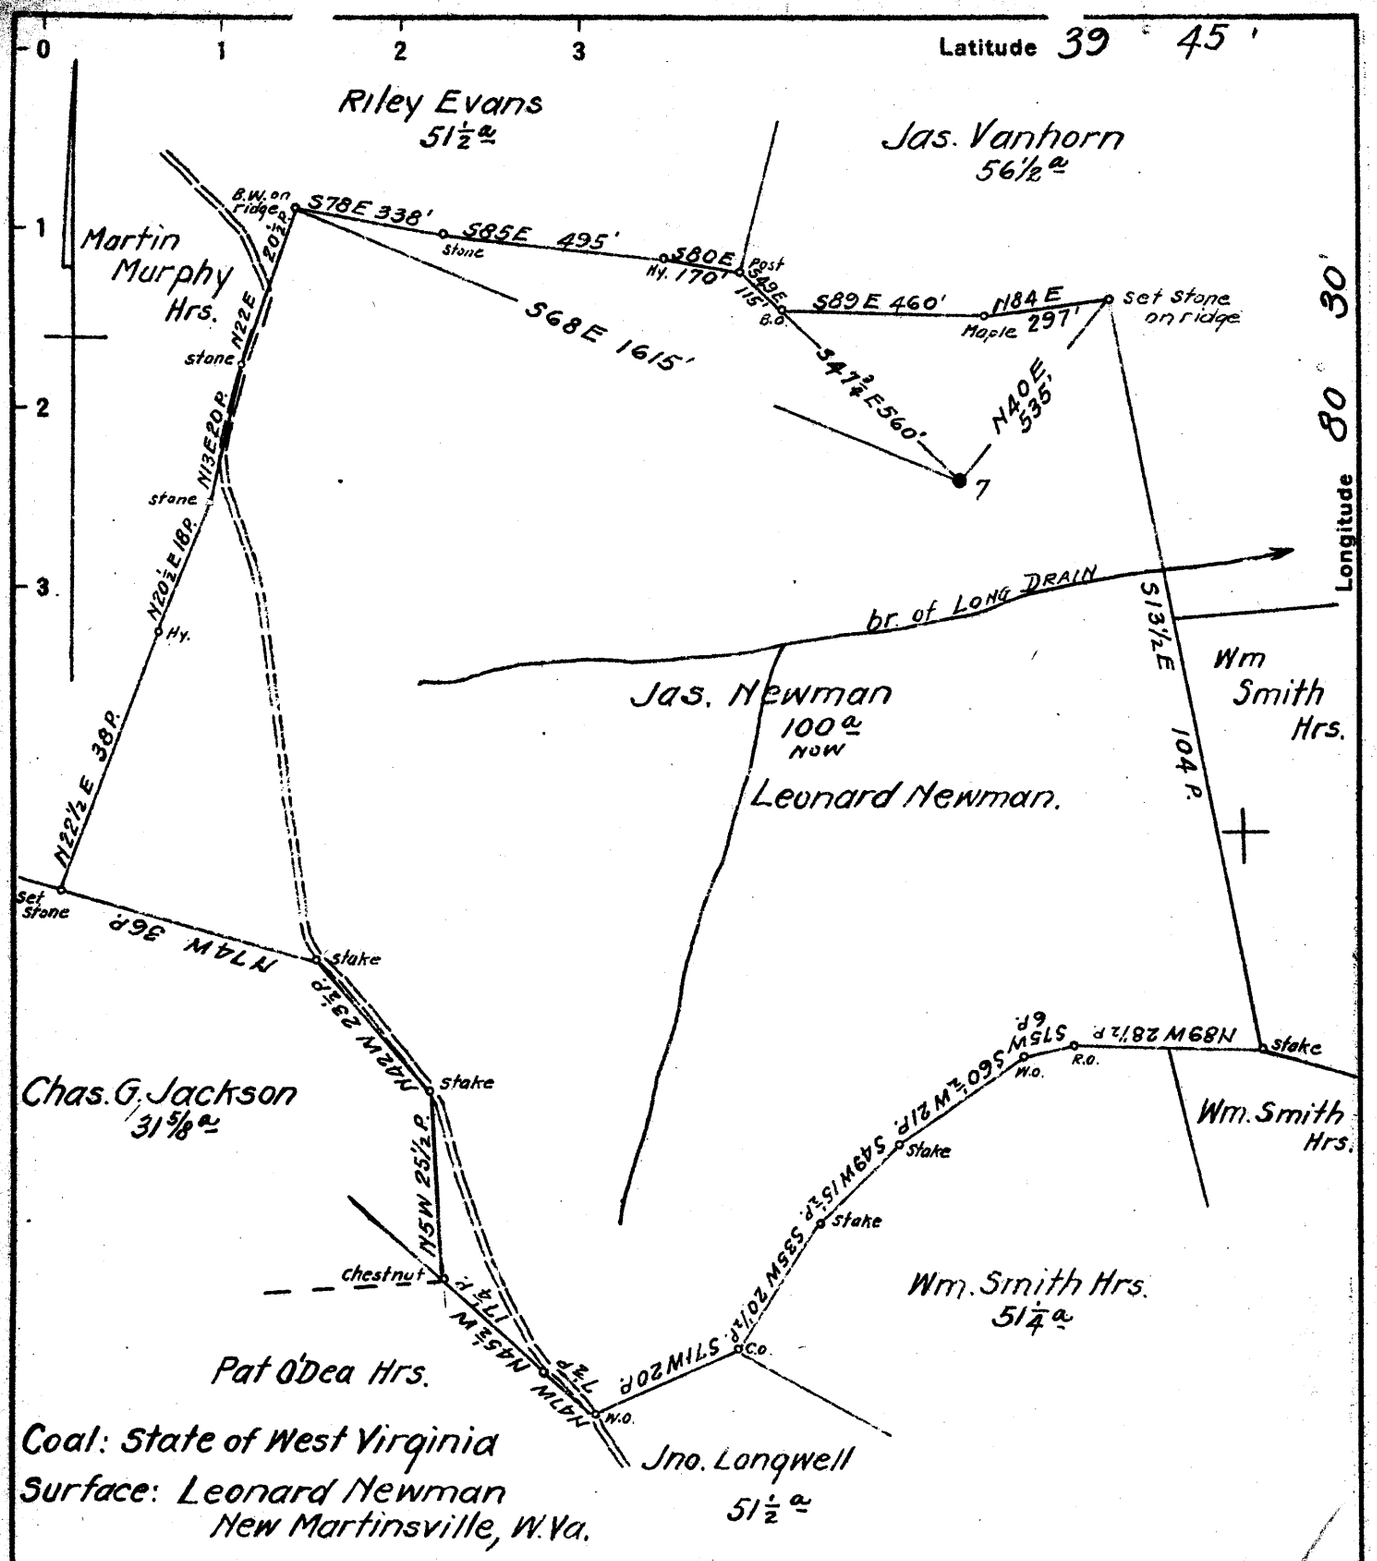

Coal: State of West Virginia
Surface: Leonard Newman
New Martinsville, W.Va.

New Location ☐
Drill Deeper ☐
Abandonment ☒

OCT 20 1941

N16-17 E7 Map N79

Company South Penn Natural Gas Co.
Address Parkersburg, W.Va.
Farm S. Newman
Tract _____ Acres 250 Lease No. 14919
Well (Farm) No. 7 Serial No. _____
Elevation (Spirit Level) 1230.33
Quadrangle Littleton
County Wetzel District Clay
Engineer E.C. Tabler
Engineer's Registration No. _____
File No. _____ Drawing No. _____
Date June 22, 1941 Scale 1" = 400'

STATE OF WEST VIRGINIA
DEPARTMENT OF MINES
OIL AND GAS DIVISION
CHARLESTON

WELL LOCATION MAP

FILE NO. WET-385A

+ Denotes location of well on United States Topographic Maps, scale 1 to 62,500, latitude and longitude lines being represented by border lines as shown.

— Denotes one inch spaces on border line of original tracing.

S. NEWMAN NO. 7 — SOUTH PENN NAT. GAS Co. — WET-385-A