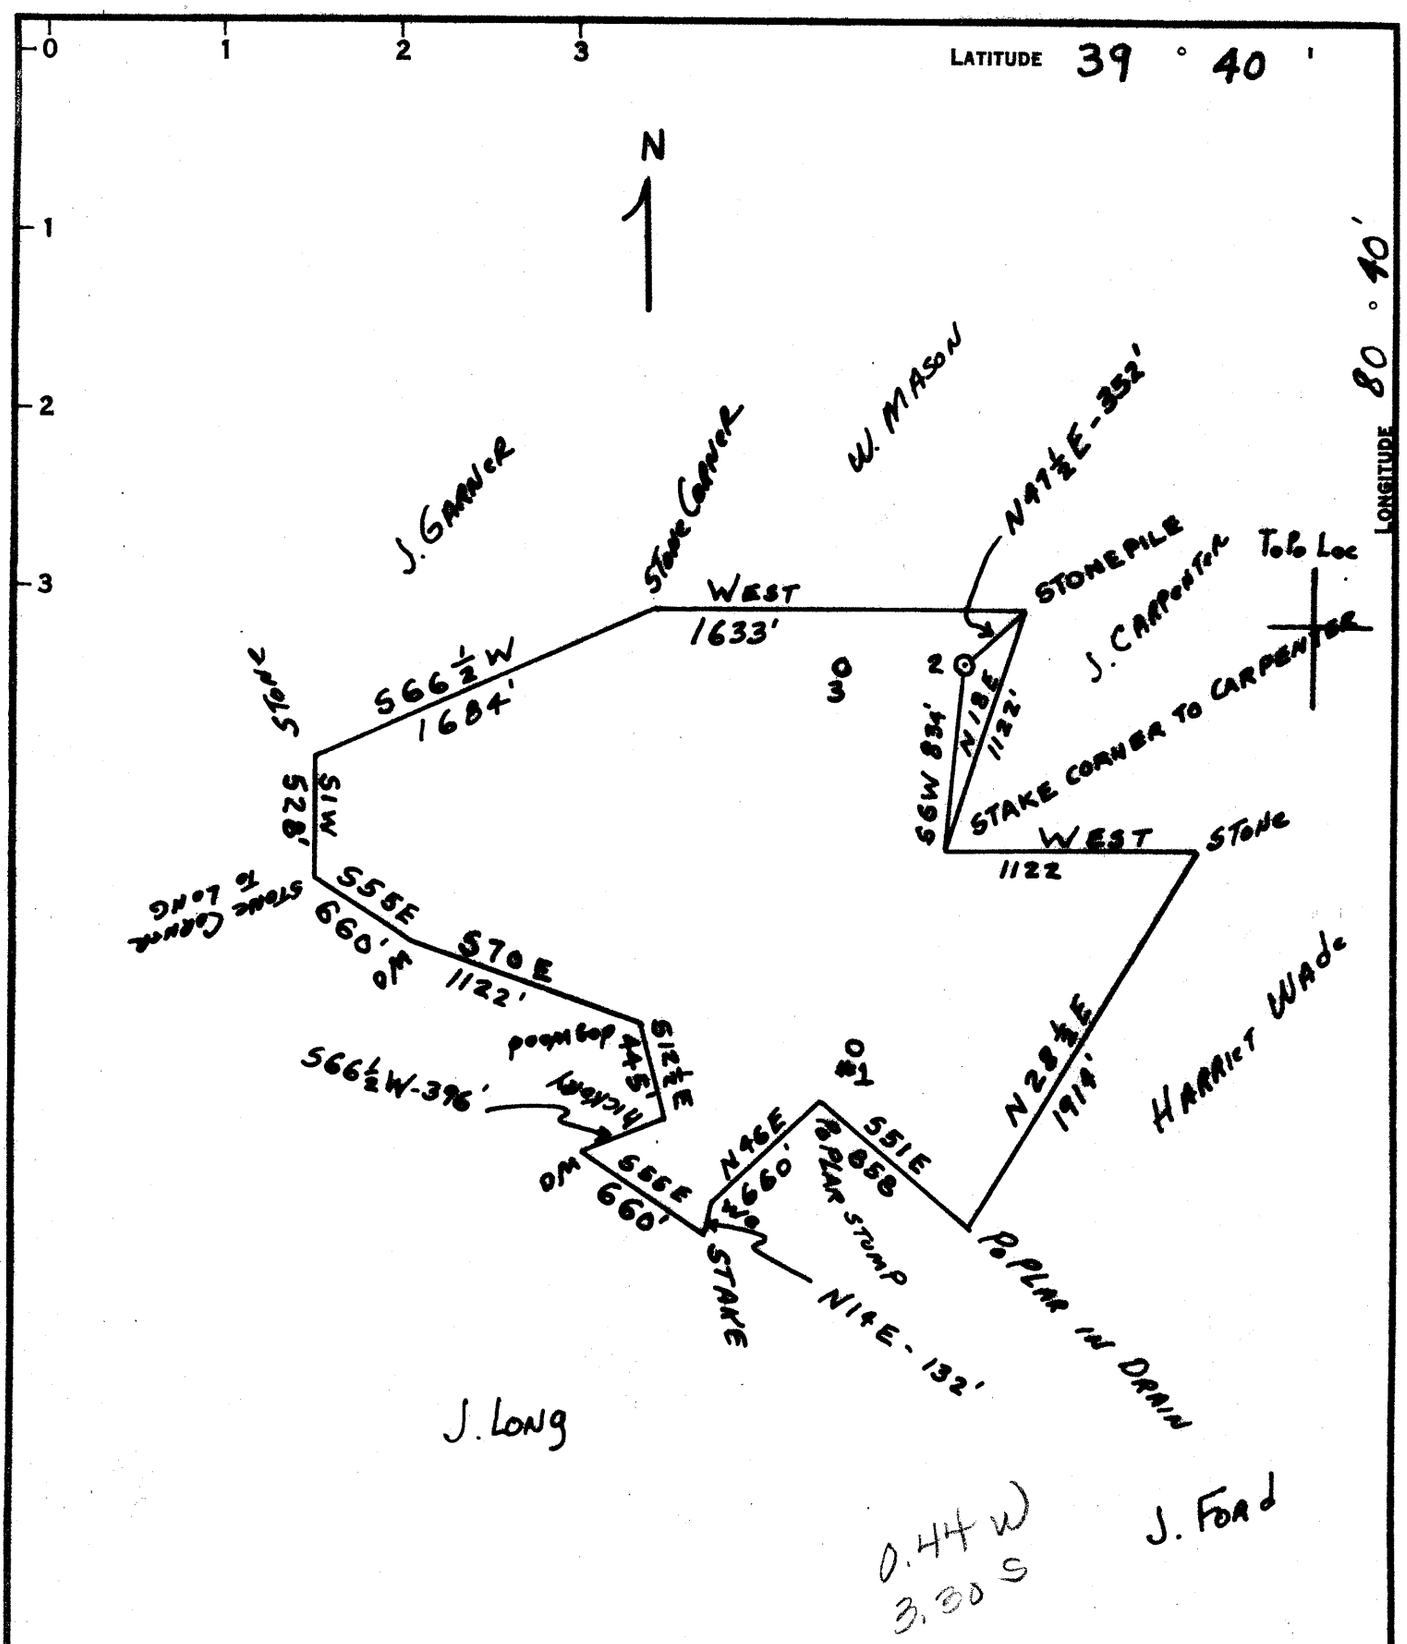

COAL OWNED BY ¾ R. White, Po Box 2, Morgantown, WVA, ¼ F.R. Huffman 90 Bonar Ave Waynesburg, PA

- [ ] NEW LOCATION
- [ ] RECONDITION
- [ ] DRILL DEEPER
- [x] ABANDONMENT

"I, the undersigned, hereby certify that this map is correct to the best of my knowledge and belief and shows all the information required by paragraph 6 of the rules and regulations of the oil and gas section of the mining laws of West Virginia."

Minimum degree of accuracy is one part in 200

Signed A. T. Gabelsen 4641

COMPANY WILLIAM CASSADY
ADDRESS 4303 Whited Drive, Vienna, W. VA
FARM Joseph Ruckman (Surf Beat Yoho)
MAP _____ ACRES 150 LEASE NO. _____
WELL (FARM) NO. 2 SERIAL NO. _____
ELEVATION (SPIRIT LEVEL) 1186
QUANDRANGLE LITTLETON - WC
COUNTY WETZEL DISTRICT GREEN
POINT OF PROVEN ELEVATION Hill 1410 - Pine Grove Tolo
FILE NO. FBK 13 Pge 77 DRAWING NO. _____
DATE 8-21-65 SCALE 1" = 800'

STATE OF WEST VIRGINIA
DEPARTMENT OF MINES
OIL AND GAS DIVISION
CHARLESTON
WELL LOCATION MAP
FILE NO. WET-1186-A

+ DENOTES LOCATION OF WELL ON UNITED STATES TOPOGRAPHIC MAPS, SCALE 1 TO 62,500. LATITUDE AND LONGITUDE LINES BEING REPRESENTED BY BORDER LINES AS SHOWN.

— DENOTES ONE INCH SPACES ON BORDER LINE OF ORIGINAL TRACING.

17 5153 (166) IMPERIAL A. & B. SMITH CO. PGH., PA.

PR 6452-363